— 59 —

— Continued on page 139 —
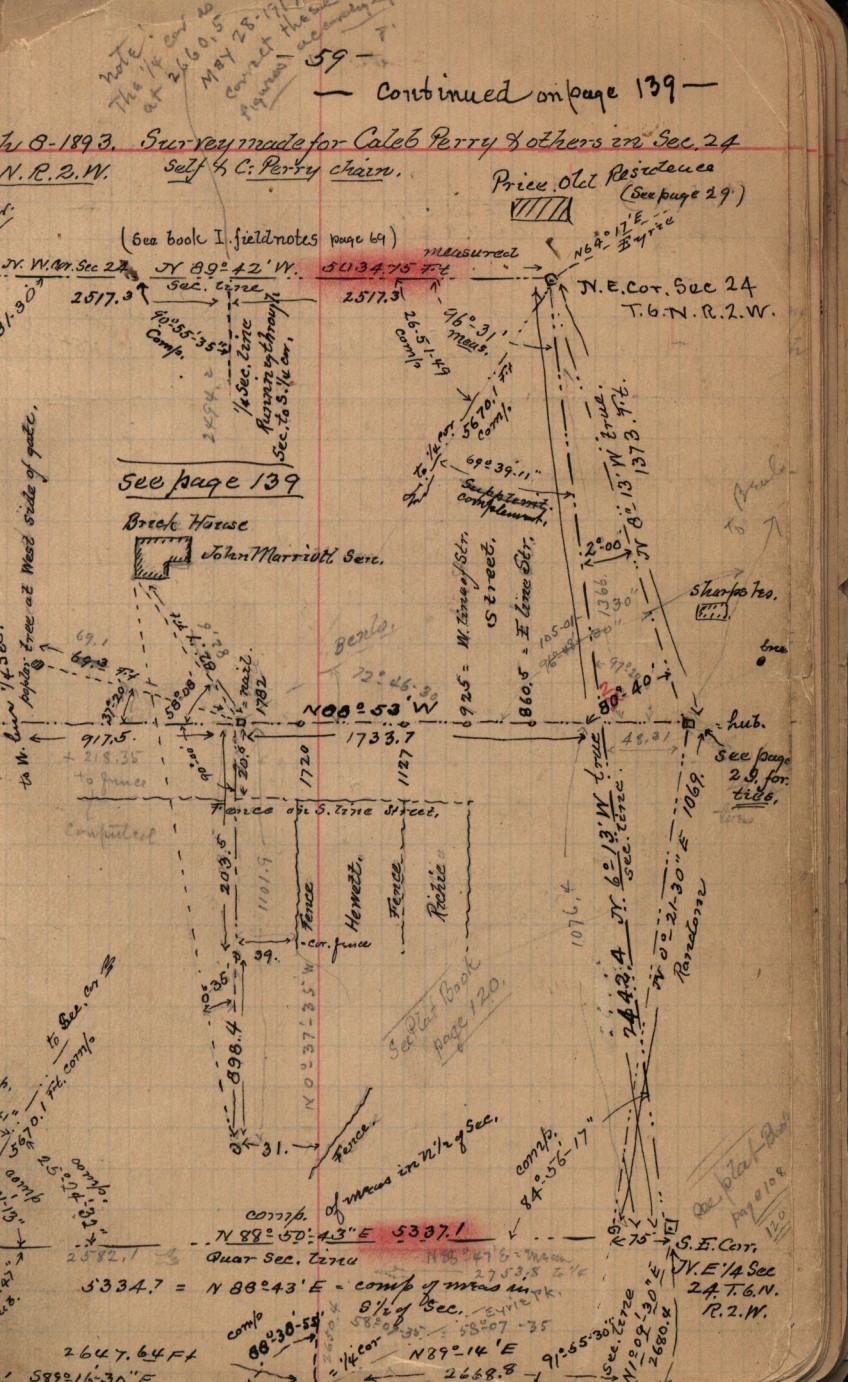
h 8-1893. Survey made for Caleb Perry & others in Sec. 24
N.R.2.W. Self & C. Perry chain.