P-306 Henry Bowns to Jas Hutchins, trustee of Statersville School district, Aug. 12-1882, $17.50 Part of S.E¼ Sec. 11, T.6.N.R.2.W. Beg. 6.21 ch E and 2.98 ch. North 1°00'E from S.W. cor. sd ¼ Sec. Running thence N33¼°E. 3. ch, N26¼°E 4.90 ch, S8°E. 2.38 ch S22¼°W 3. ch. - S57½°W 3.28 ch, to beg. 8/10 of 1 a

Rec. Aug 12-1882,

K-403. Henry Bowns to Sylvester L. Perry, June 9-1877 $2.50 Pt S.E¼ Sec. 11 T.6.N R.2.W. Beg. S.W. cor. sd ¼ Sec. N2.40 ch, 158.4 N89°E 6.27 ch, to West side of Str. S1°W 2.58 ch, on W. side of street, W6.21 ch to beg. containing 1.55

H.507. John Hudman to Sylvester Perry, Pt.N.E¼ Sec. 14, T.6.N-R.2.W-Beg. N.W. cor. sd ¼ S19.27 chs, E.7.73 chs, N0.50 chs, E.6.00 chs N.4.30 chs, S40°W. 2.40 chs, N74°W. 3.60 chs N42°W. in Mill Cr. 7.30 chs, N1°E 9.26 ch W. 3.96 chs to beg. 12.72 a

See Plat Book page 109

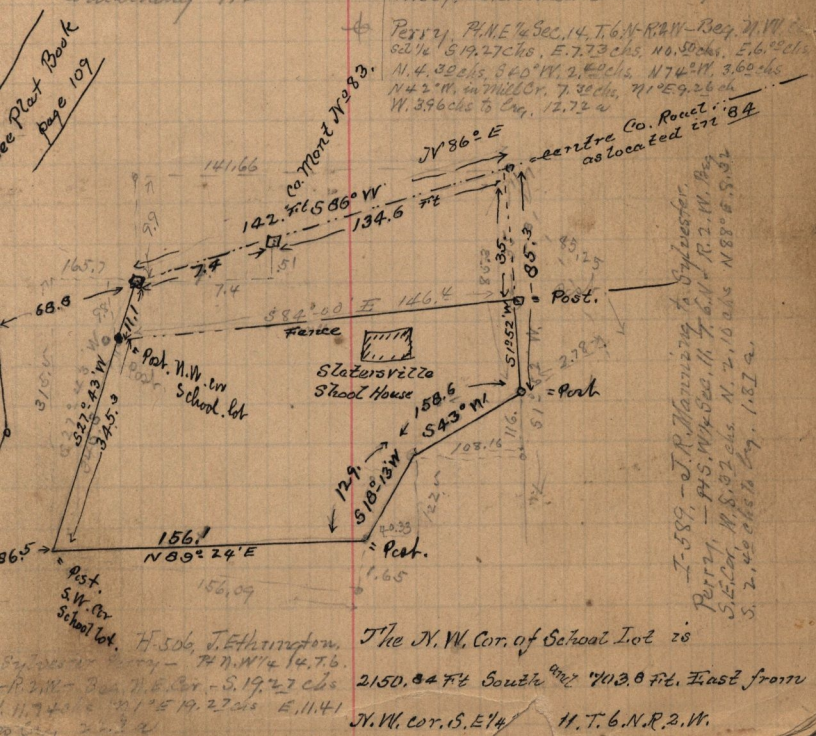

H-506, J. Ethington, Sylvester Perry - Pt N.W¼ 14, T.6. -R.2.W - Beg. N.E. Cor. - S.19.27 chs E.11.74 chs N1°E 19.27 chs E.11.41 ... 22.7 a

The N.W. Cor. of School Lot is 2150.84 Ft South and 703.8 Ft. East from N.W. cor. S.E¼ 11. T.6.N.R.2.W.