March 17-1893.

urvey made for Mrs. Warner in S.E¼ Sec. 35. T.7.N.R.2.W.
in Harrisville, Jos. A. Taylor, & Samuel B. Warner, Chairmen,

= East gable of For West Meeting house.

Sketch of premises of S.B Warner. — in Harrisville —

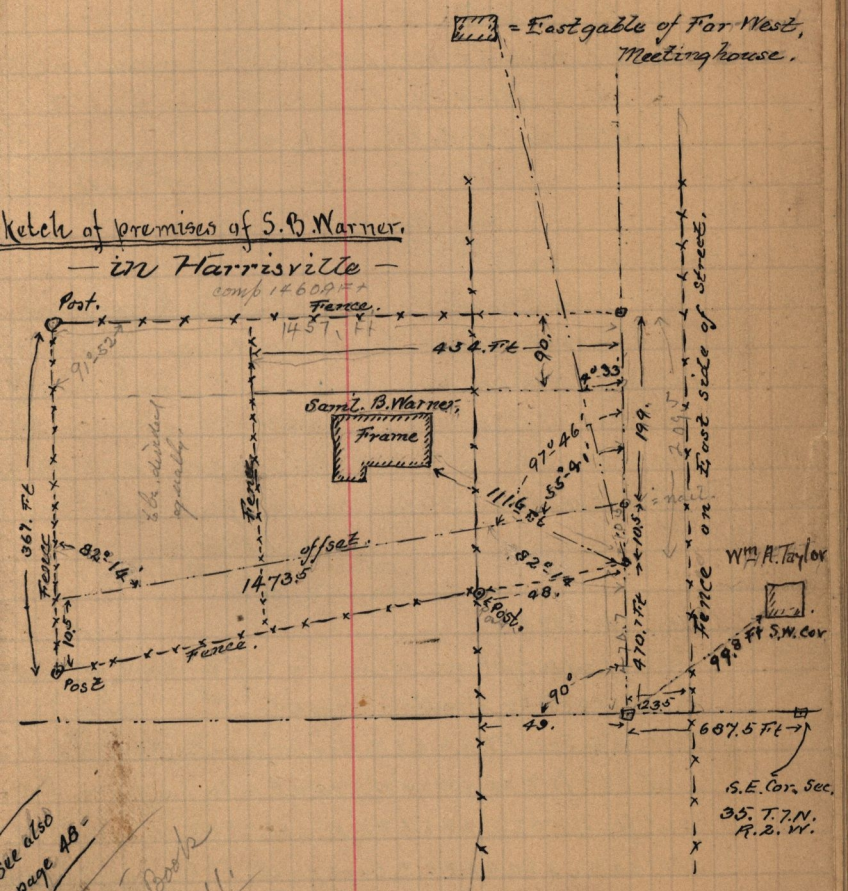

See also page 48

also see plat book page 111.