See M-P. 2

380.34
198
182.34
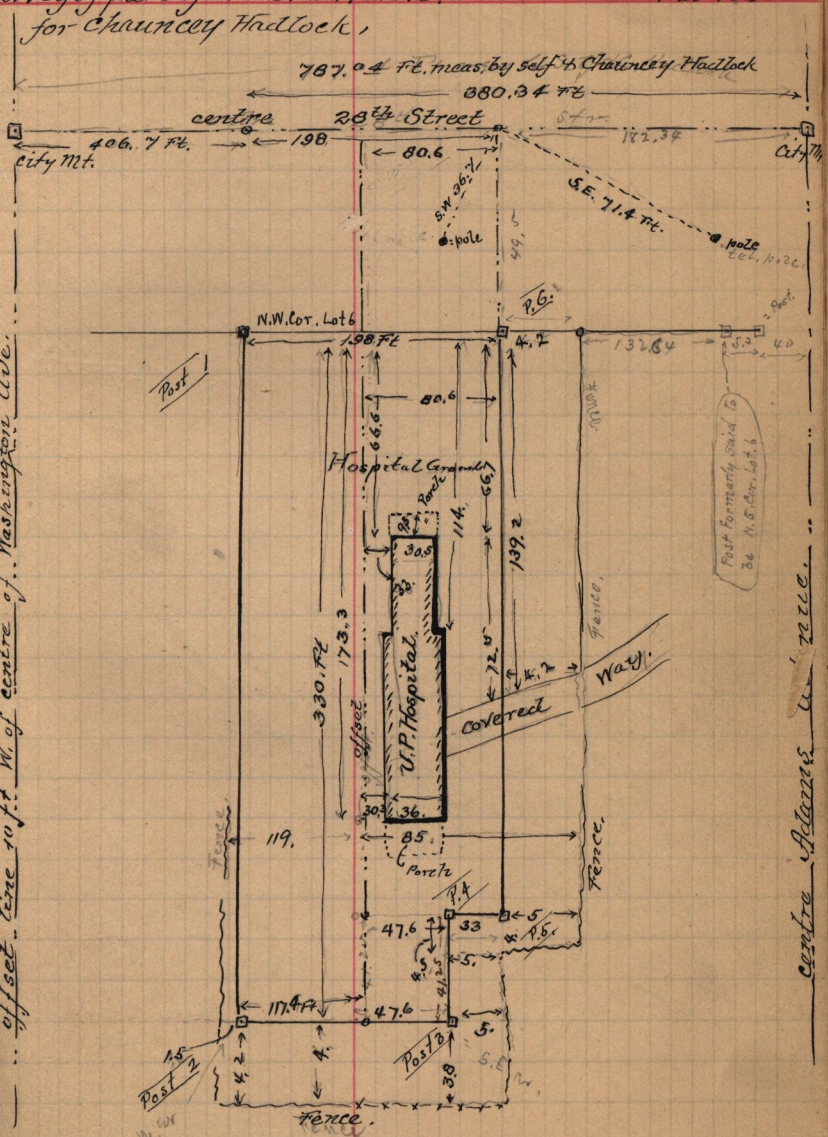
Survey of part of Lot 6. B.A. S.O.S. March 27-28-1893.
for Chauncey Hadlock,