West Ogden Heights Addition.

Survey, made April 10-1893.
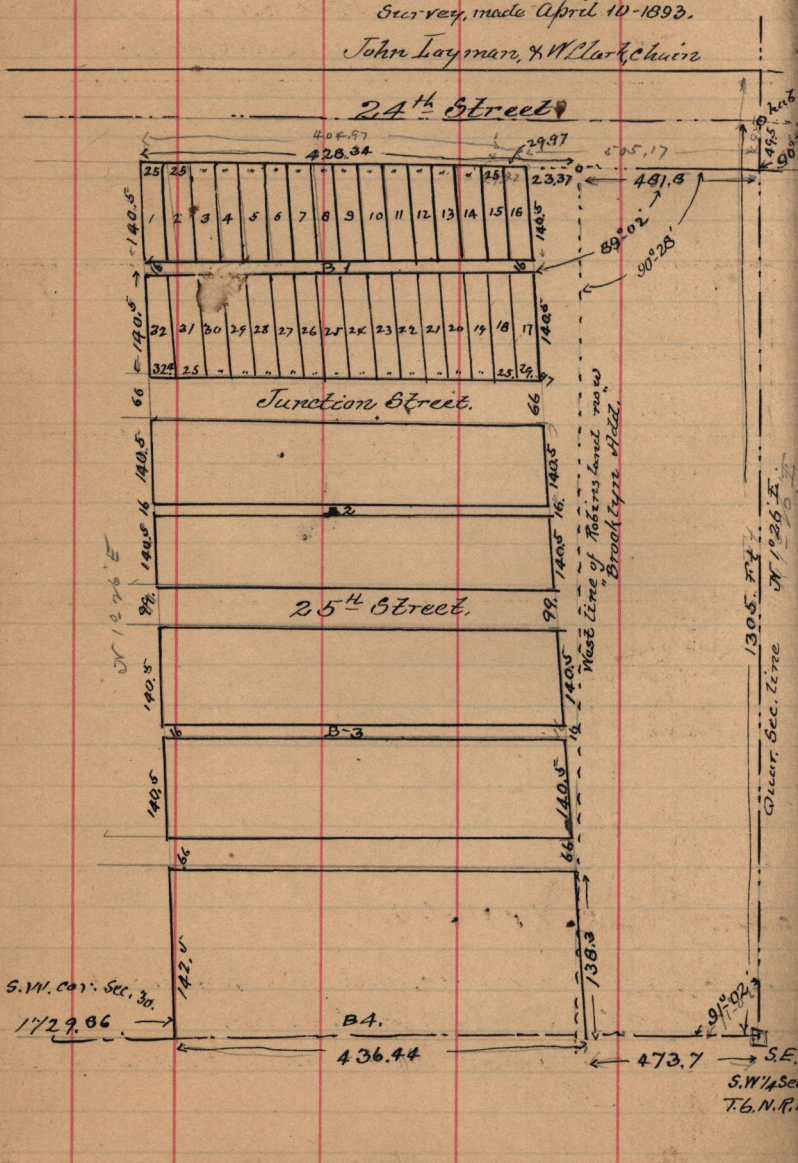
John Layman, & W. Clark, Chain