


April 14-1893.

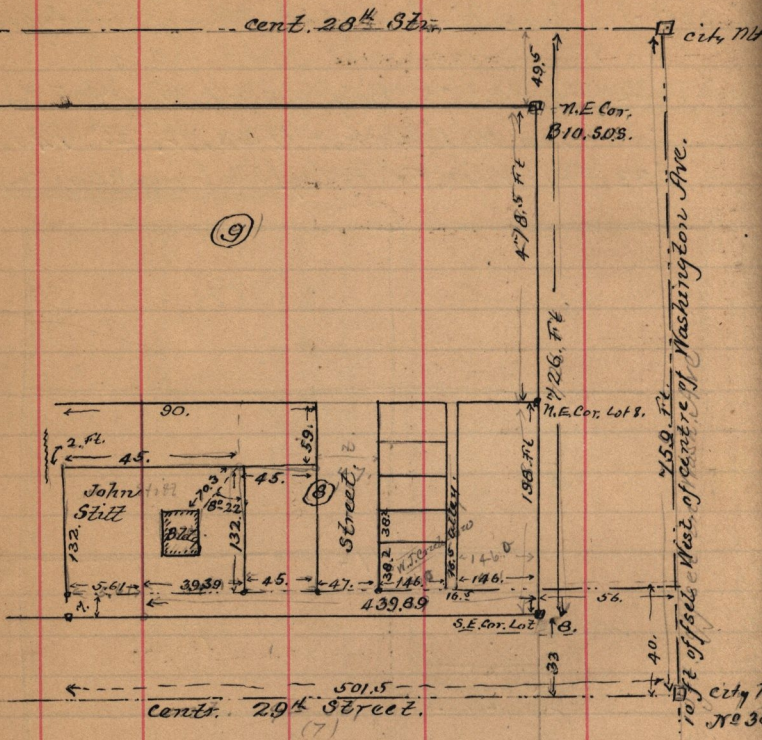

(18-43) W<sup>700</sup> F. Critchlow to Stitt, Jan'y 2-1892.  
 Pt Lots 8-10. B10. S.O.S. OCS. Beg. 7. ft. N. of 400  
 ft. W. of S.E. Cor., sd Lot 8, N 132. Ft. W 45. Ft. S 13  
 E. 45. Ft. to beg.

Surveyed April 14-1893.  
 John Layman, W. Clark, chainmen,  
 fees \$5.