


April 22-1893.

Survey made for W. W. Funge
to locate S. Line Lot 4. B5. PA. OCS

Centre 2⁷/₈ Street,

Lincoln Ave.
Centre 704.5
464.5

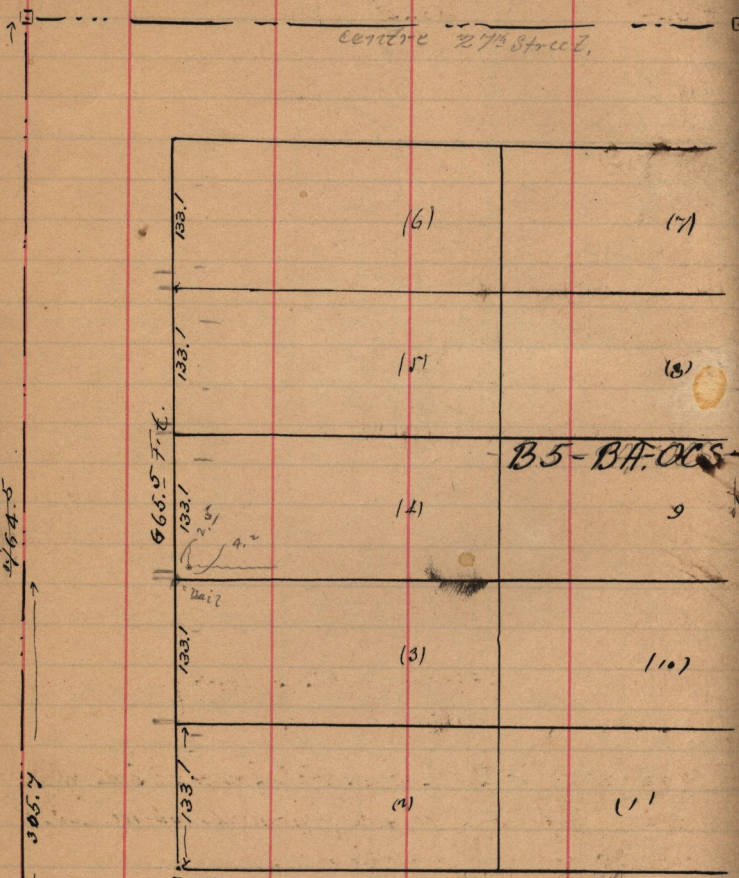

Fence post.

fence post

61.25
 S.W. 58.75
 Ostr. Signle Post.
 City Mont.
 NE 66.20
 SE 68.25
 T.P.

10ft. North of centre.
 28¹/₈ str.
 766.5