See Plat Book page 119

April 26-27-28- -1893

Survey made for Wm Flinders, A. Haynes, and others, at Hooper. in S.W¼ Sec. 14, and Sec. 22-23. 15. T. 5. N. R. 3. W.
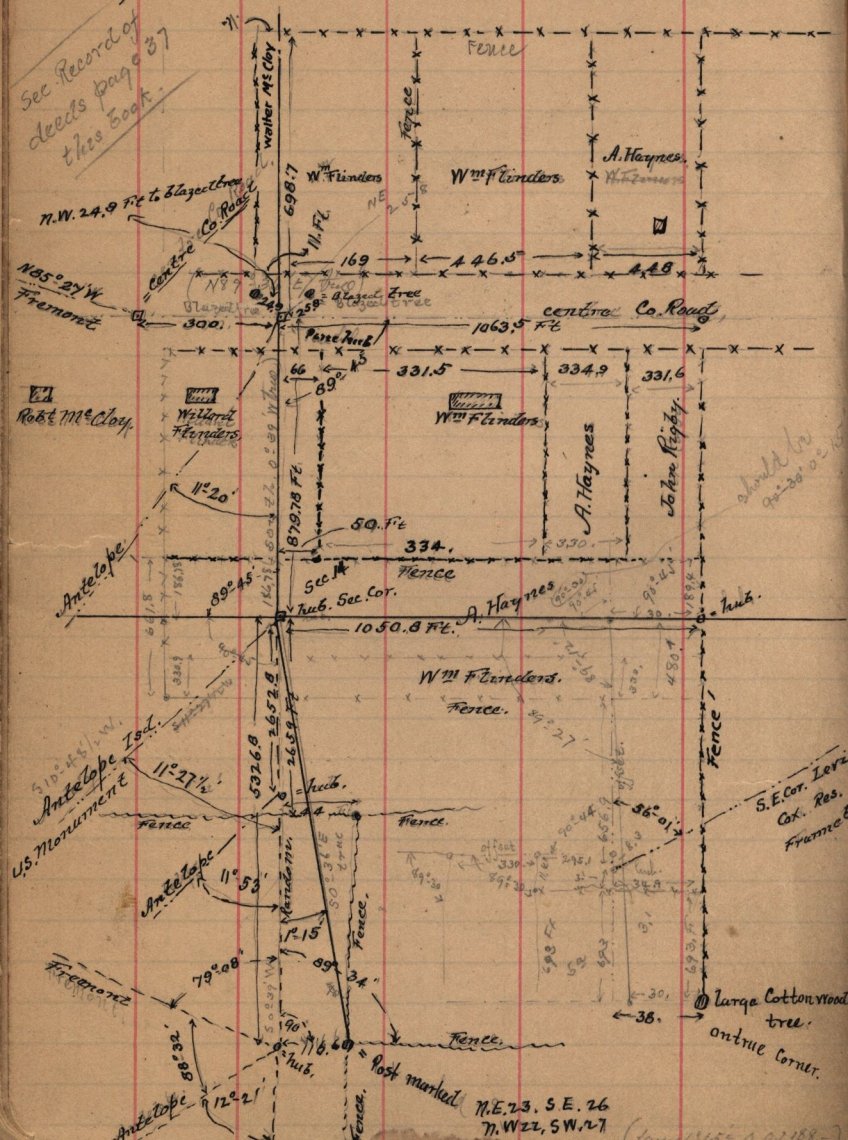
See Record of deeds page 37 this Book.