20-396. Elijah Shaw &r. to Wm Bailey, May 4-1893. $1.00
Pt N.W 1/4 Sec. 29. T. 7. N. R. 1. W. Beg. S.E. Cor. said 1/4 Sec.
W. 15.20 chs, N 5°00' W. 20. chs. more or less, to centre
of Co. Road, S 60°30' E. along centre of said road, 20.
chs. more or less. to E line of said 1/4 S. S 10.35 ch to beg.
27. a. more or less.

May 8- 1893 - Survey of North Ogden Cemetery.

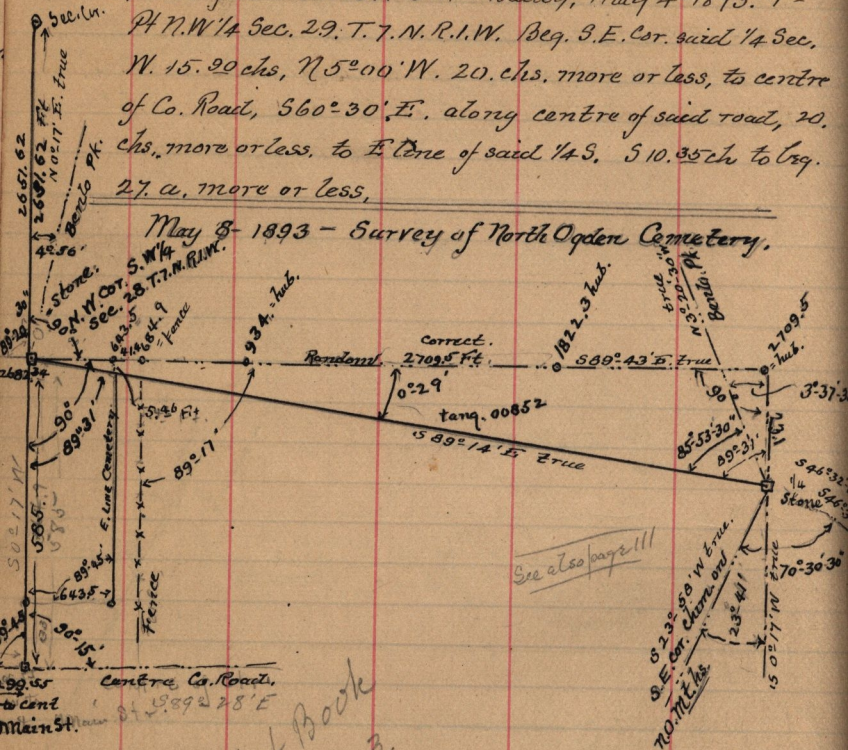

ties to N.W. Cor of S.W 1/4 Sec. 28. as above
N.E 55.5 Ft to cor. post.
N.W 10.1 . poplar tree 2'/2" dia.
W. 6°.. to post in fence.
N.W. 27.1 to large boulder (top.)

(ties to centre St #99.55 Ft E.o Cent. Wash Ave
N.W. 25.3 . cor. post.
S.E 33.6 Cedar cor post.