Cemetery 9-10-11-12-

Survey of the North Ogden, May. 8-1893

-14-384.— A.C. Bishop, Probate and Co. Judge to The

UNION CEMETERY ASSOCIATION. Nov. 3-1892.

1/. Pt S.W¼ Sec. 28. T. 7. N. R. 1. W. Beg. N.W. Cor., S. 6.86 chs, East, 9.75 chs, N. 6.86 chs. W. 9.75 chs. to beg.

Recorded Nov. 3-1892.

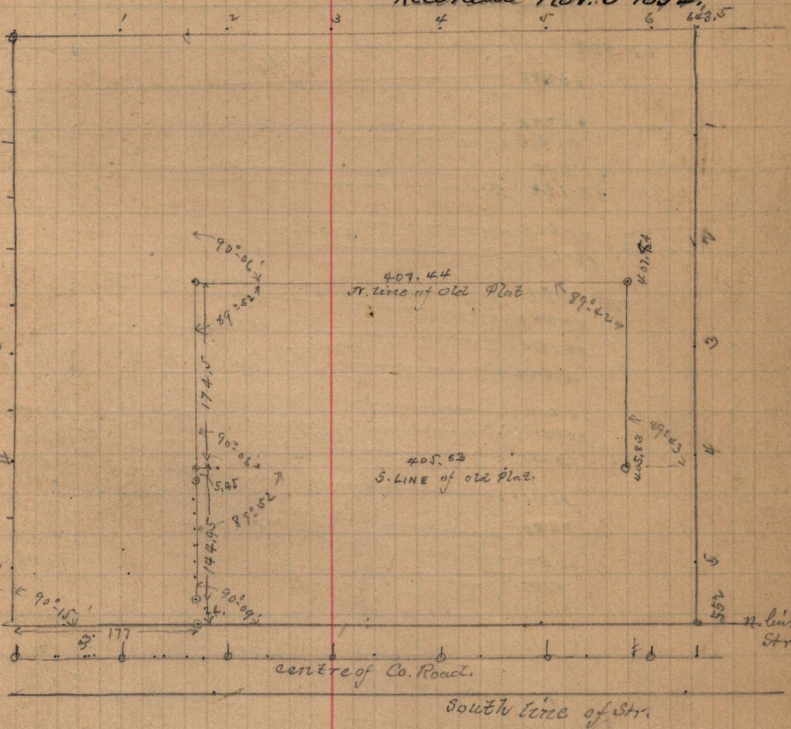

Plat Book
page 113