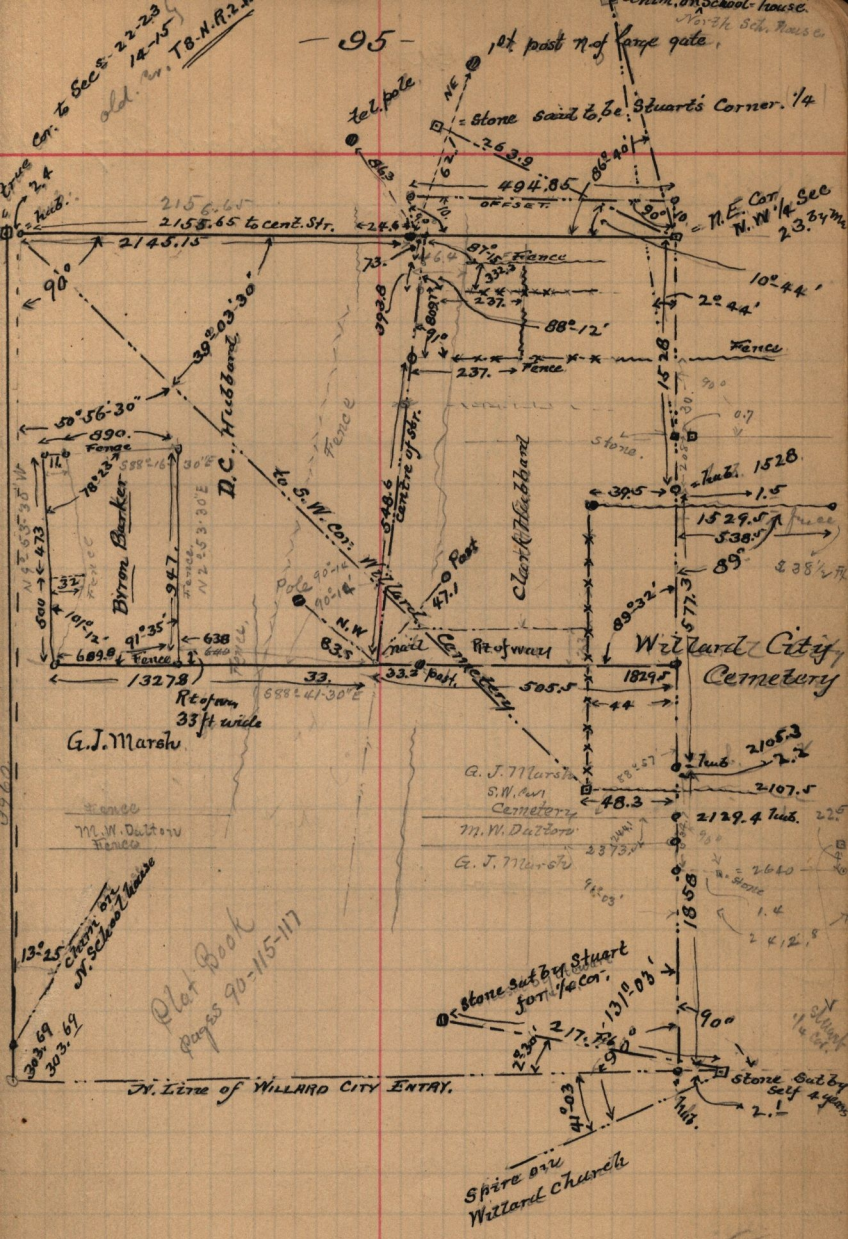
— 95 —
Cor. to Sec. 5 - 22-23 14-15
T8.N.R.2.E.
Old
1st past N of Fence gate.
Tel. pole
Stone Scribed 1/4 Sec. Stuart's Corner. 1/4
N.E.
263.9
494.85
Offset
N.E. Cor. N.W. 1/4 Sec 23.34 mi
2158.65 to cent. Str.
2145.15
90°
87° Fence
10° 44'
2° 44'
88° 12'
Fence
237.
D.C. Hubbard
39° 03' 30"
50° 56' 30"
890.
Fence
Byron Barker
947.
473
600
91° 35'
638
689.8
Fence
13278
Rt of way 33 ft wide
G.J. Marsh
to S.W. Cor. N.W.
Centre of Str.
Fence
Pole
Post
47.1
Clark Hubbard
Rt of way
Willard City Cemetery
89° 32'
571.3
1529.5
538.5
1.5
1528
Stone
Tree
Tub.
2105.3
2107.5
48.3
2129.4 Tub.
G.J. Marsh
S.W. 1/4
Cemetery
M.W. Dalton
Fence
1858
Stone Set by Stuart for 1/4 Cor.
13° 03'
217.7
90°
Stone Set by Self & Yeo
Tub.
2.1
41.03
Spire on Willard Church
N. Line of Willard City Entry.
13° 25'
Chord to N. School House
303.69
Plat Book Pages 90-115-117
Old Road
Fence
M.W. Dalton Fence
G.J. Marsh
Fences
Stone
2640
1.4
2.4
2.8
Stone
Tree
Fence
Fence
Fence