


Willard City Survey

77. W. Cor. N.E. 1/4 Sec. 23
T. 8. N. R. 2. W
By Self.

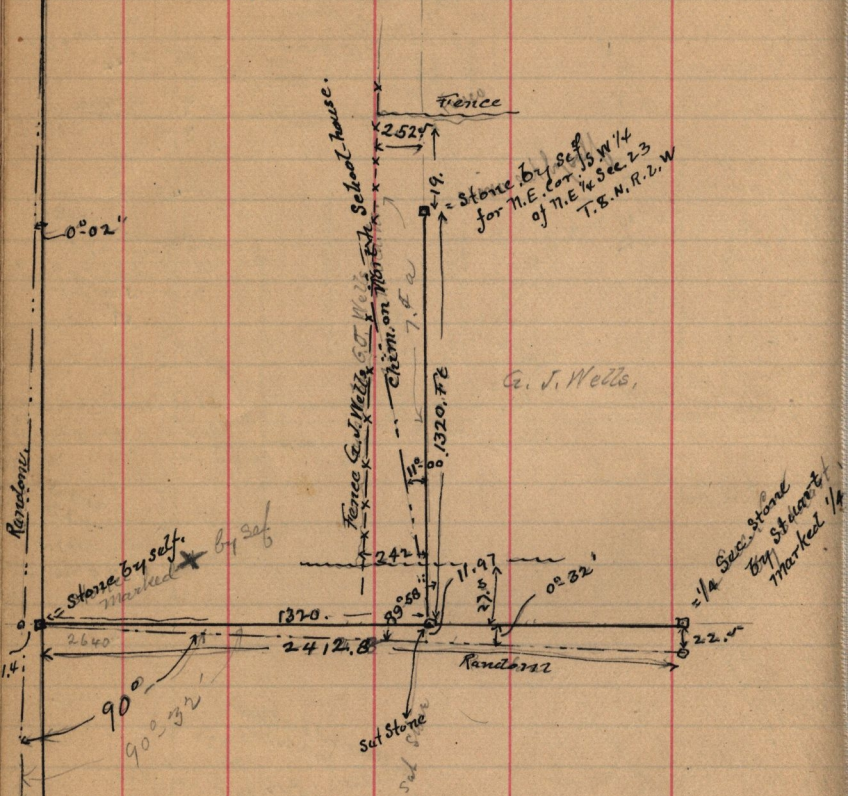

Flat Book pages 90-115-117

on N. line Willard City Entry see page 95 (also Book F. 247)