


May-16-1893

Willard City Survey

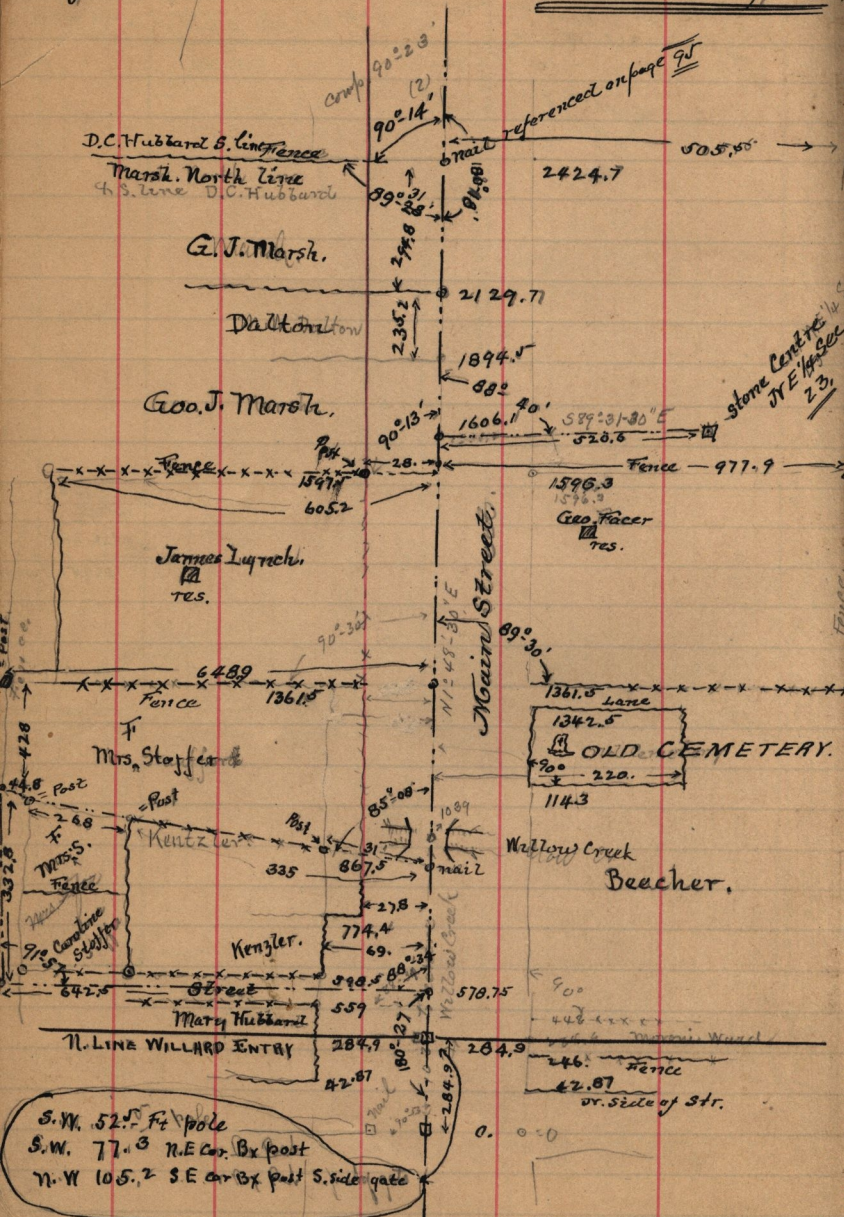

S.W. 52.5 Ft pole  
 S.W. 77.3 N.E. cor. Bx post  
 N.W. 105.2 S.E. cor Bx post S. side gate