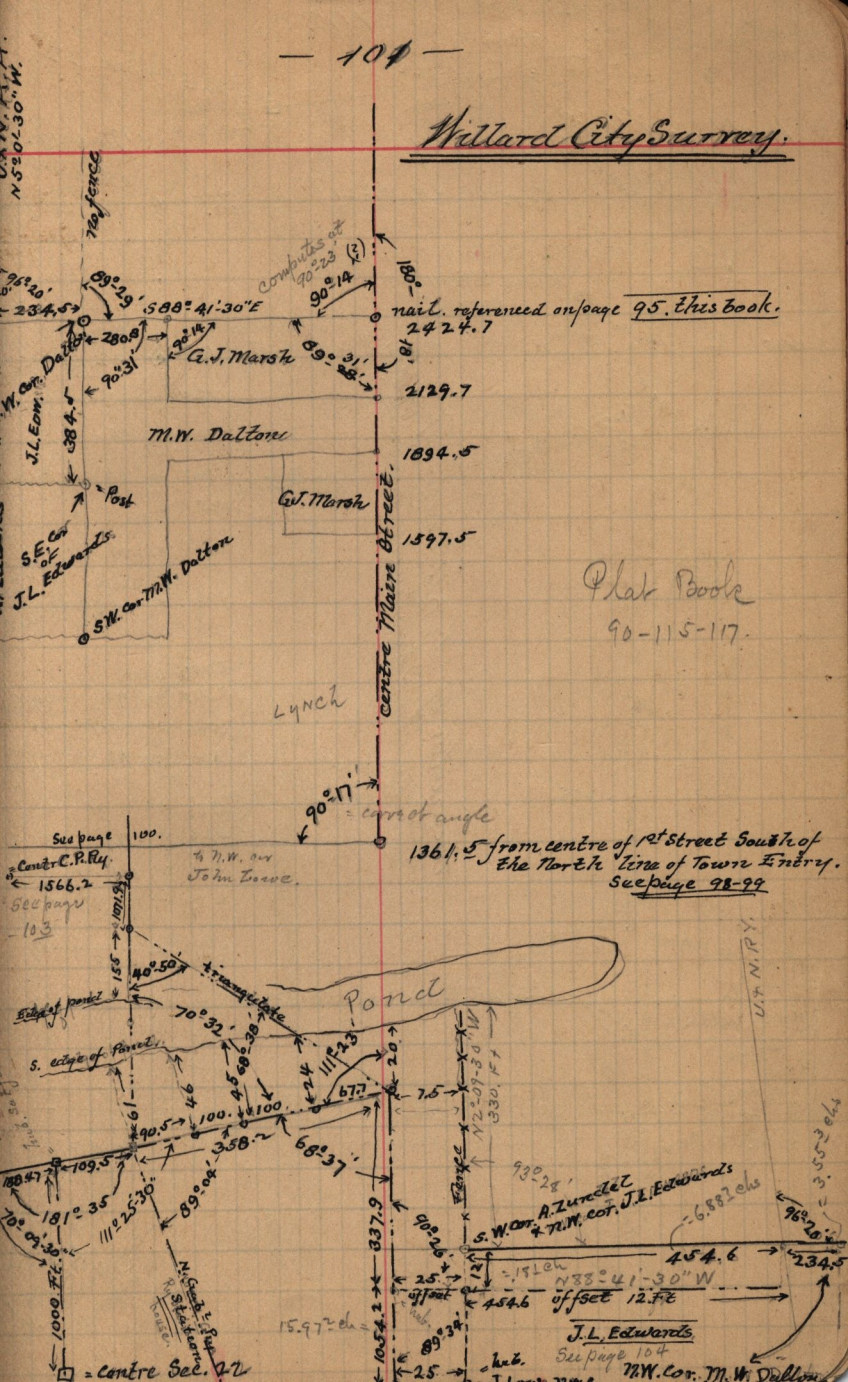Willard City Survey.