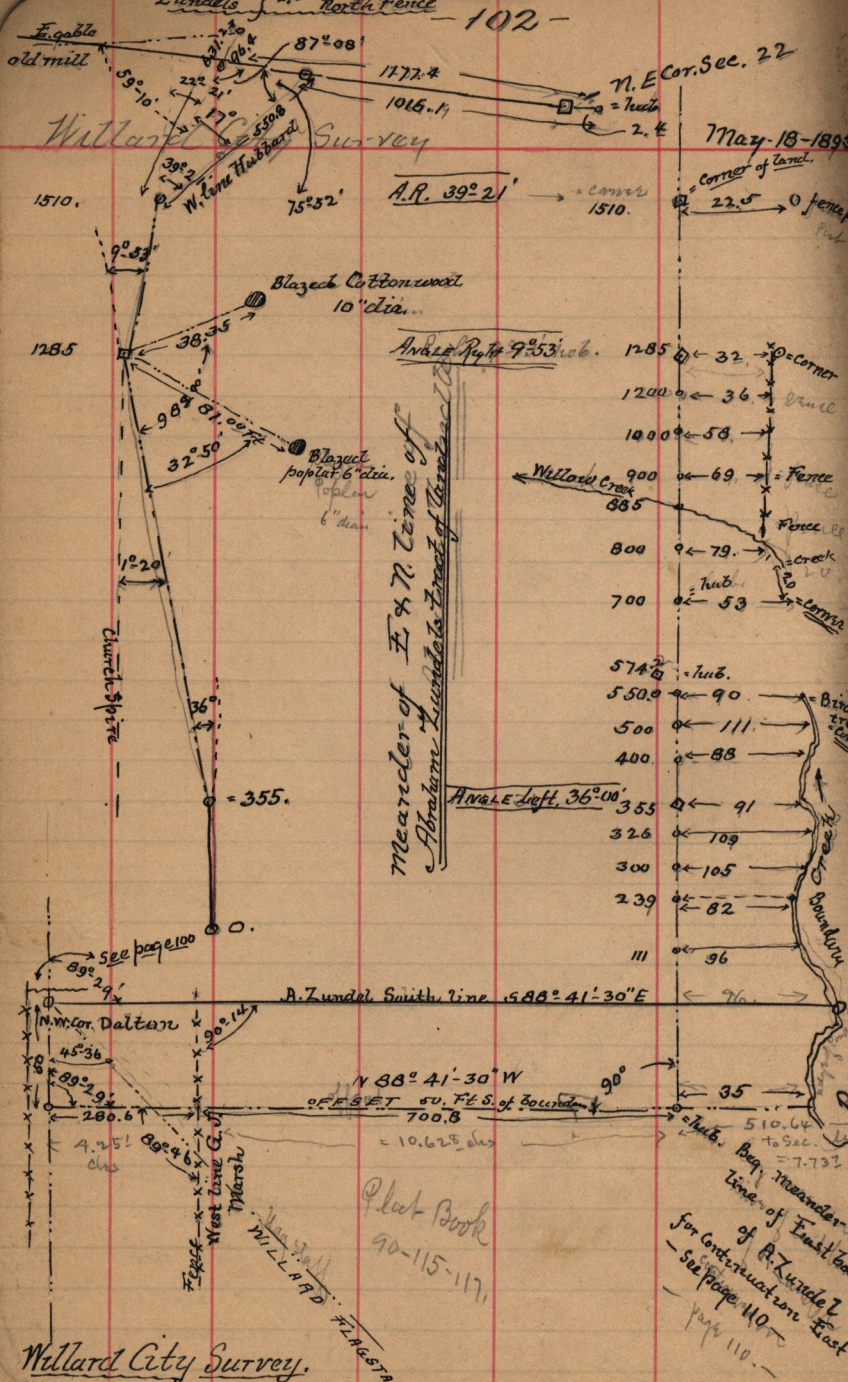
Zundels North fence
102
E. gable old mill
87°-08'
1777.4
1016.1
N. E Cor. Sec. 22
= Iron
2.4
May-18-189
Willard City Survey
39°-10'
22°-21'
17°
550.8
W. line Hubbard
39°-21'
75°-32'
A.R. 39°-21'
= corner
1510.
= Corner of land.
22.5
0 fence
9°-33'
Blazed Cottonwood 10" dia.
1285
38°-35'
Angle Rt. 9°-53' nob.
98°-81'-08"
32°-50'
Blazed poplar 6" dia.
Poplar 6" dia.
1°-20'
Church Spire
36°
= 355.
0.
Meander of E & N. line of Graham Zundel's tract of land
Angle left, 36°-00'
Willow Creek
Fence
Creek
Boundary
See page 100
89°-29'
A. Zundel South line S 88°-41'-30" E
N.W. Cor. Dalton
90°-14'
45°-36'
89°-29'
280.6
N 88°-41'-30" W
OFFSET 50. Ft S. of boundary
700.8
= 10.62 Chs
90°
35
= Hub.
510.64
to Sec.
= 7.732
4.25 Chs
89°-46'
West line G.L.
Marsh
Fence
WILLARD
FLAGSTA
Beg. Meander Line of East bo of A. Zundel
For Continuation East See Page 110
Plat Book 90-115-117
Willard City Survey.