


Willard City Survey

May 19-189

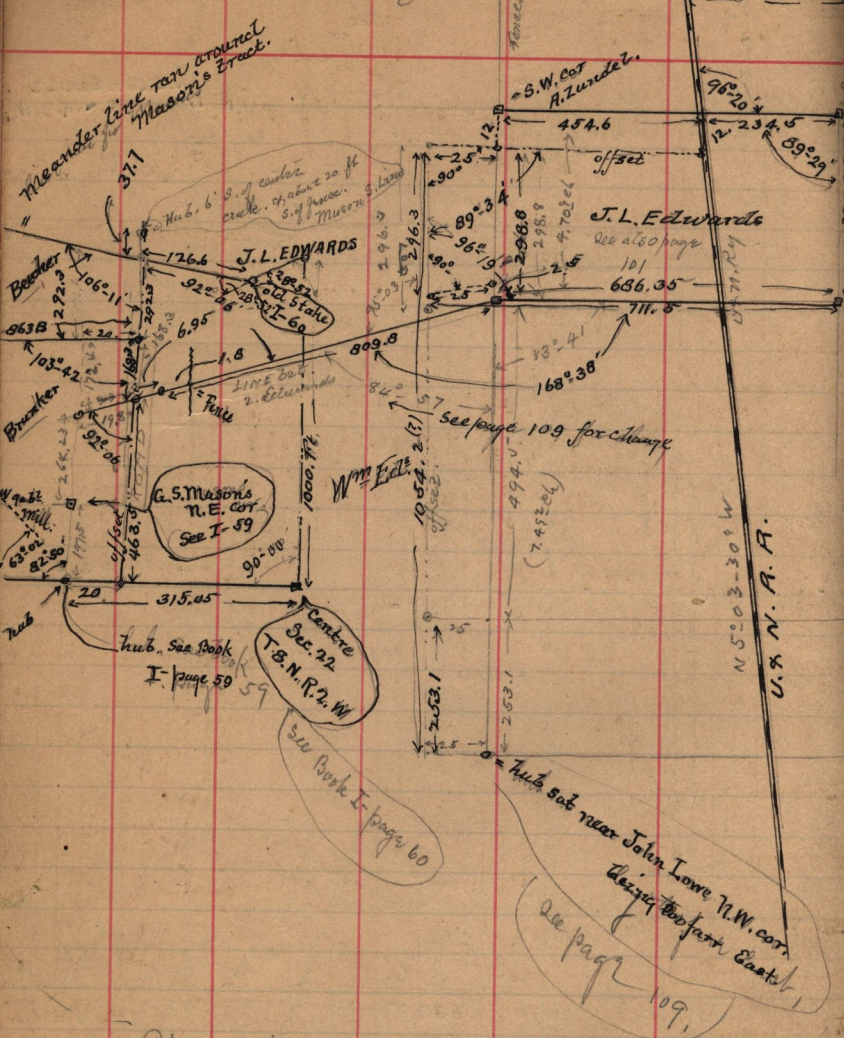

Plat Book
90-115-117