


Willard City Survey

May 20 - 1893

From page 105

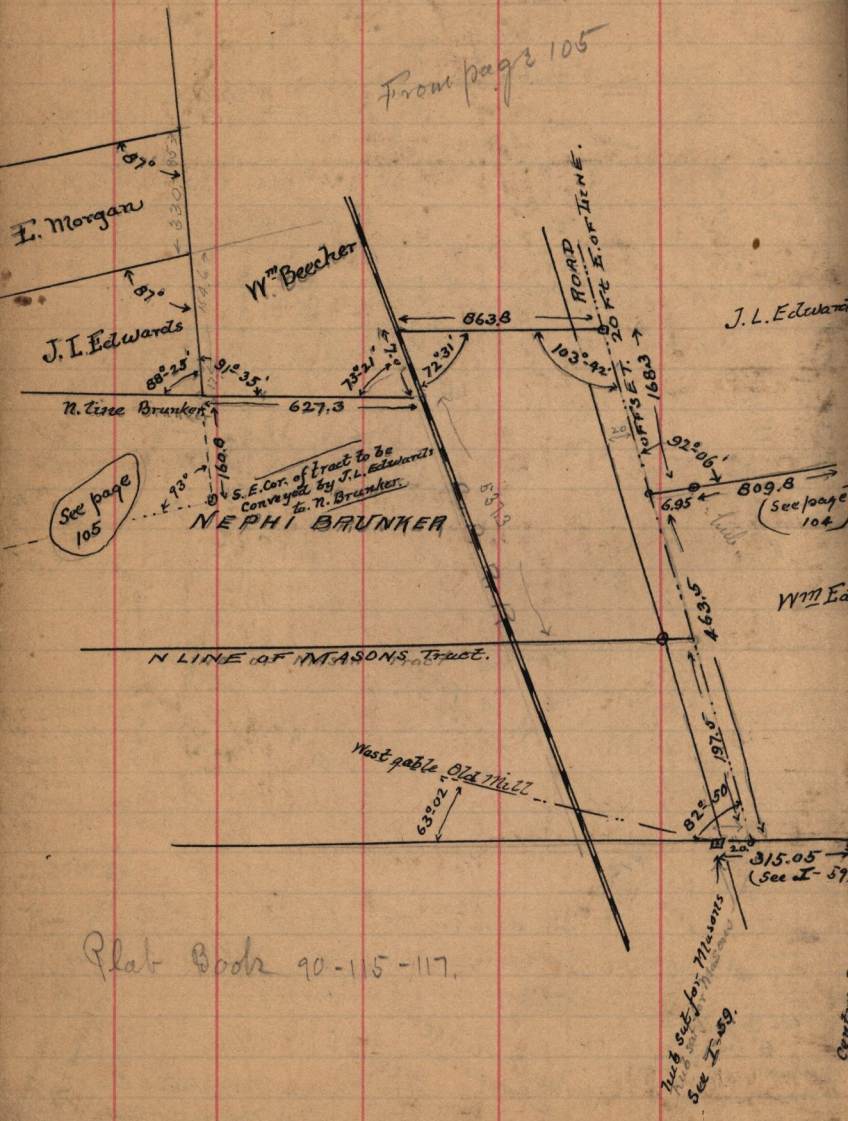

Plat Book 90-115-117.