


- 120 -

June 16-1893

Survey made for I. R. Pa
of Lots 6-7, B. 7. 0.5 acre P.A.

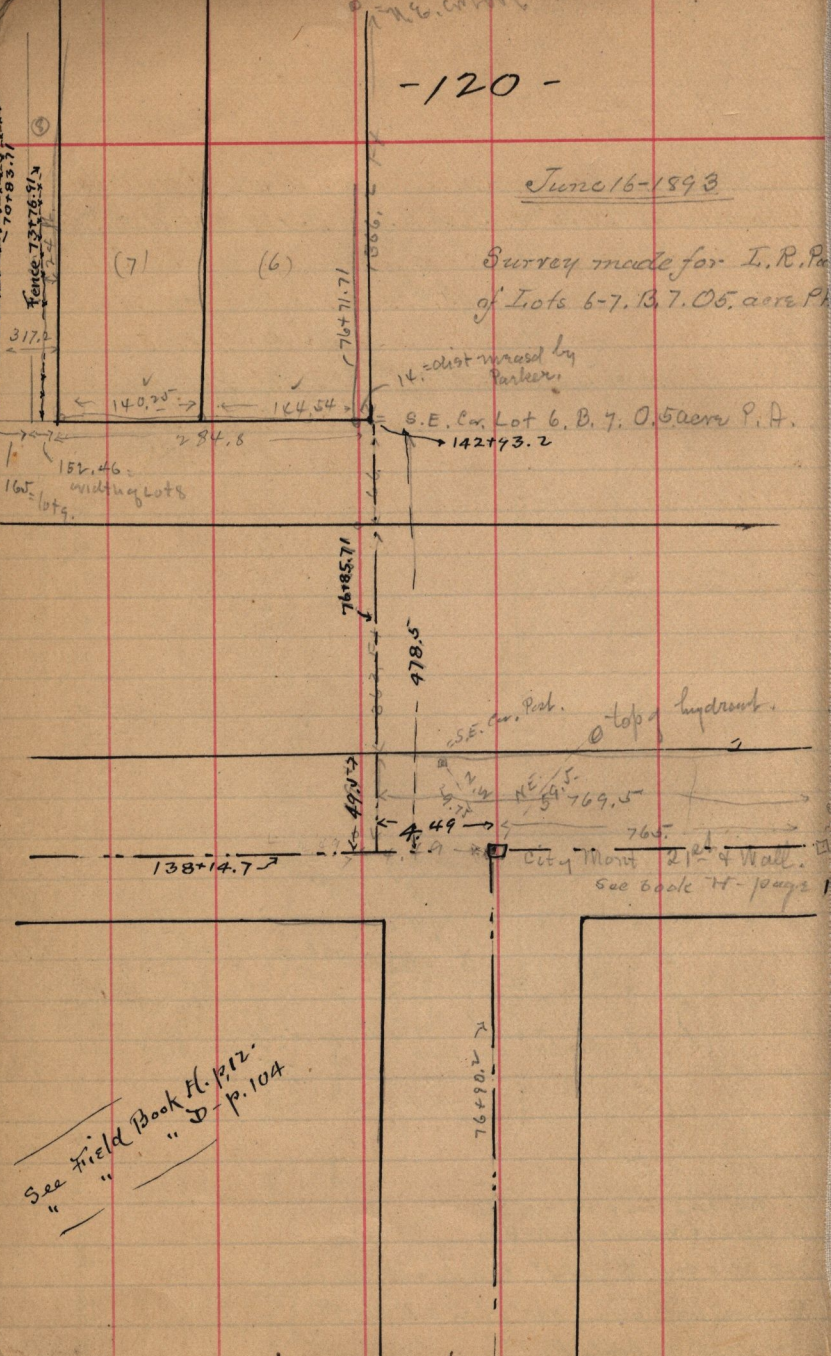

See Field Book A. p. 12.
" " " D. p. 104.