


122

June 20-1893

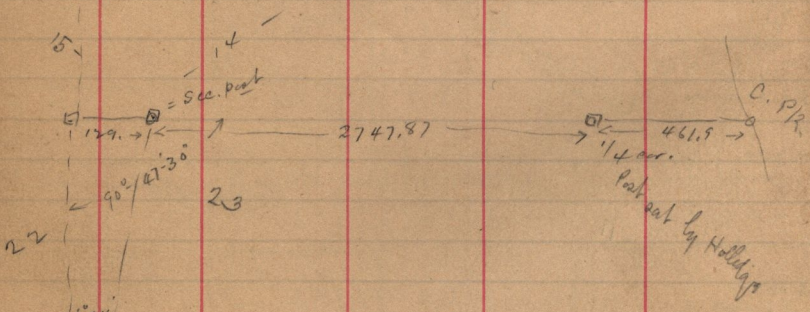

⊙ = S.W. Cor Sec 23  
T. 7 N. R. 22 W. sec 23