


July 29-1893

to N.W. cor. 1/4 Sec.

Survey of Pebble Park

Lee Curtis & S.T. Camp
Chas.

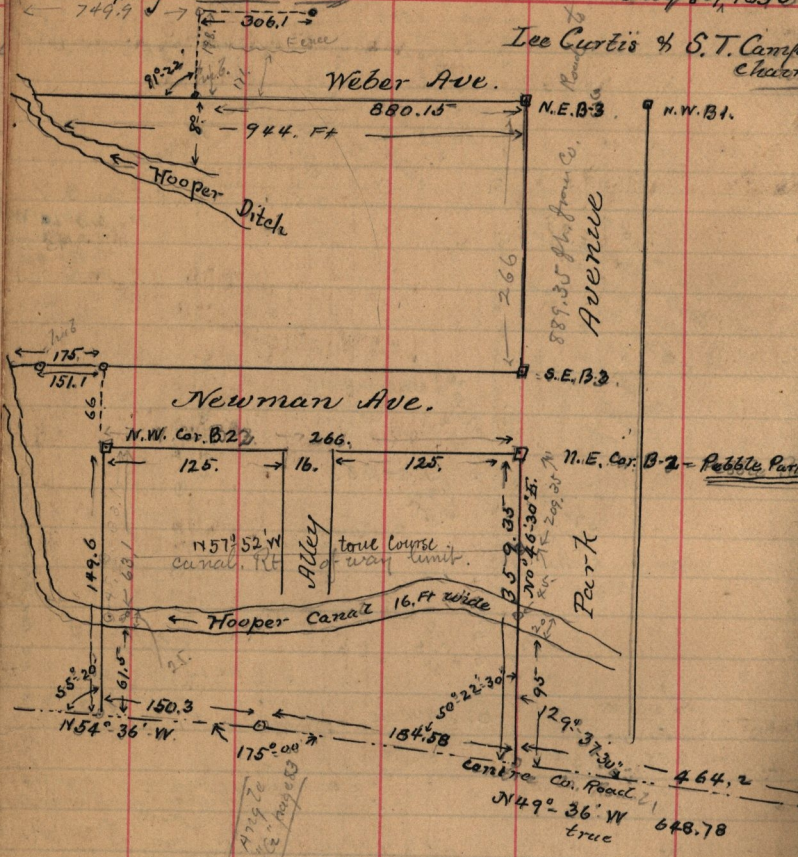

Alley
See page 13