Survey made for DAVID Adams, Plain City July 12-1893

Jos. V. East & David Adams, Chainmen

Book "F" page 177 -

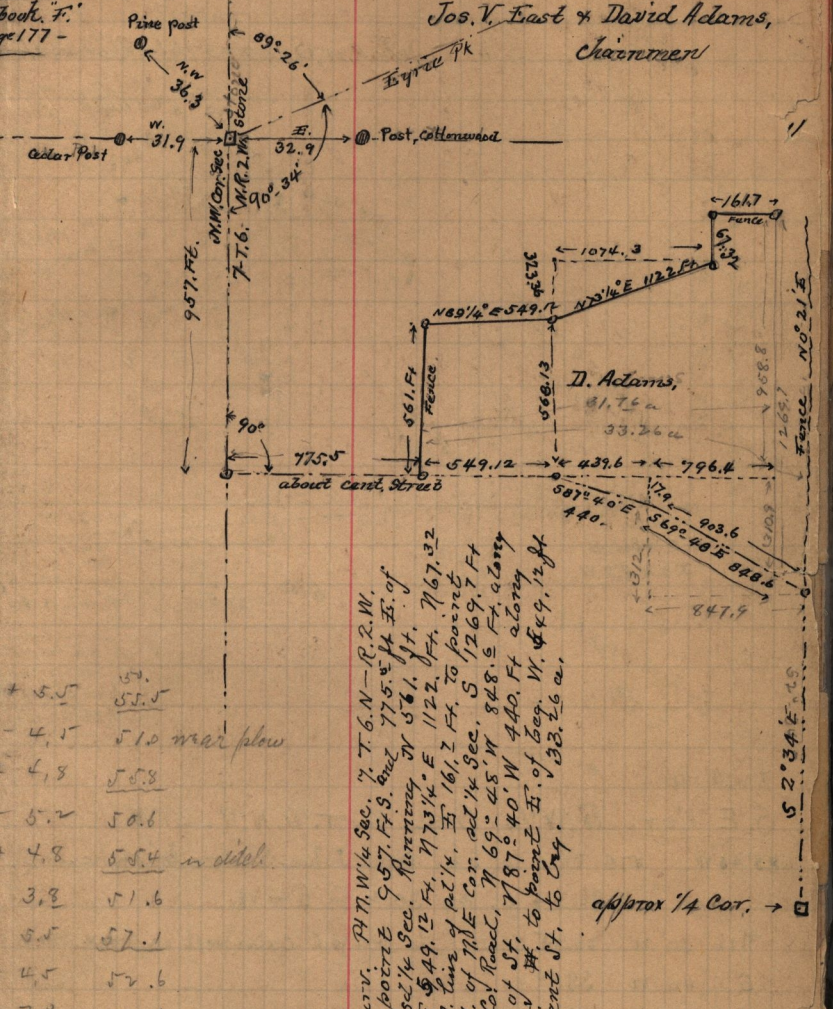

Des. of above Surv. Pt N.W. ¼ Sec. 7 T. 6. N — R. 2. W.
Beg. at a point 957 Ft. S. and 775.5 Ft E. of
N.W. Cor. Sec. 7 Running S 1°1' W. 561. Ft. 767.32
N 89¼° E 549.12 Ft. N 73¼° E 1122 Ft. to point
Ft. to N. line of Sec. E 161.7 Ft. to point
66. Ft W. of NE Cor. Sec. S 1269.7 Ft
to cent. Co. Road, N 69° 45' W 848.6 Ft along
Centre of St. N 87° 40' W 440. Ft along
cent. St. Ft. to point E. of Beg. W. 549.12 ft
along cent St. to Beg. 33.26 a.

+ 5.5	54.
	55.5
- 4.5	51.0 near plow
- 4.8	55.8
- 5.2	50.6
4.8	55.4 in ditch
3.8	51.6
5.5	57.1
4.5	52.6
7.0	59.6
5.8	53.8
9.2	50.4 in swale