

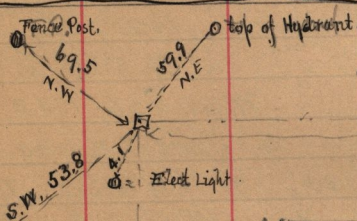


Survey of Lot 22, B2, "Kings Add," Aug. 22-19
for W.S. Hall

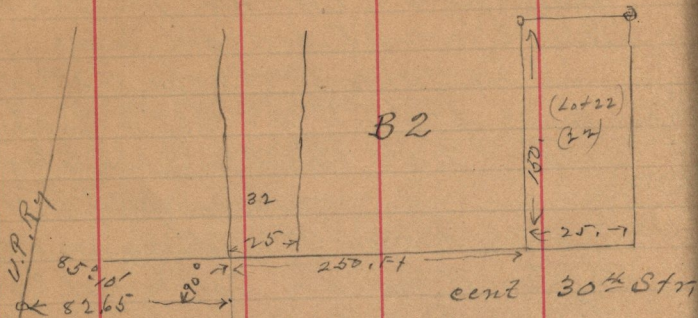

Aug 23 - 1893
cent 23rd St
763.85

hack in, blazed
Cottonwood tree
Crowned tree

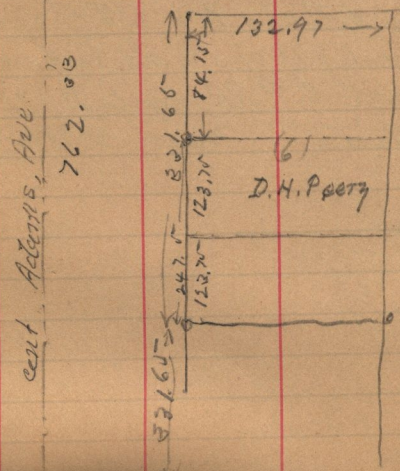

B-30, P.A.