


August 29<sup>th</sup> 1890

Survey made for John Fife of  
land under fence claimed by him in S. 1/4 & N. 1/4  
Sec. 30, T. 6, N. R. 1. W. - him self & son assisted

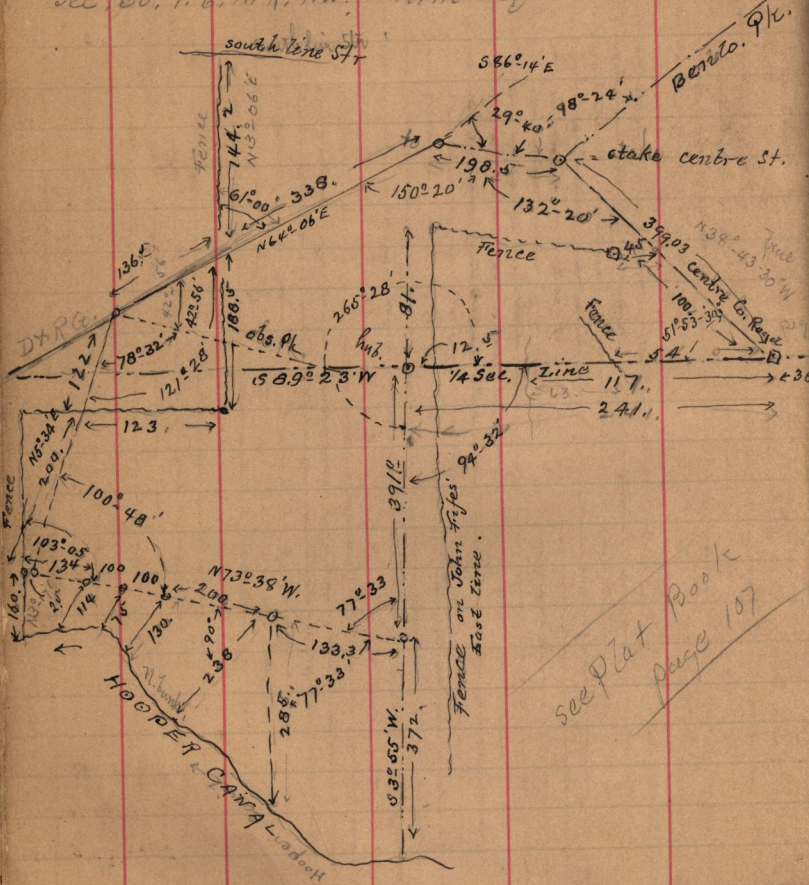

see Plat Book  
page 107