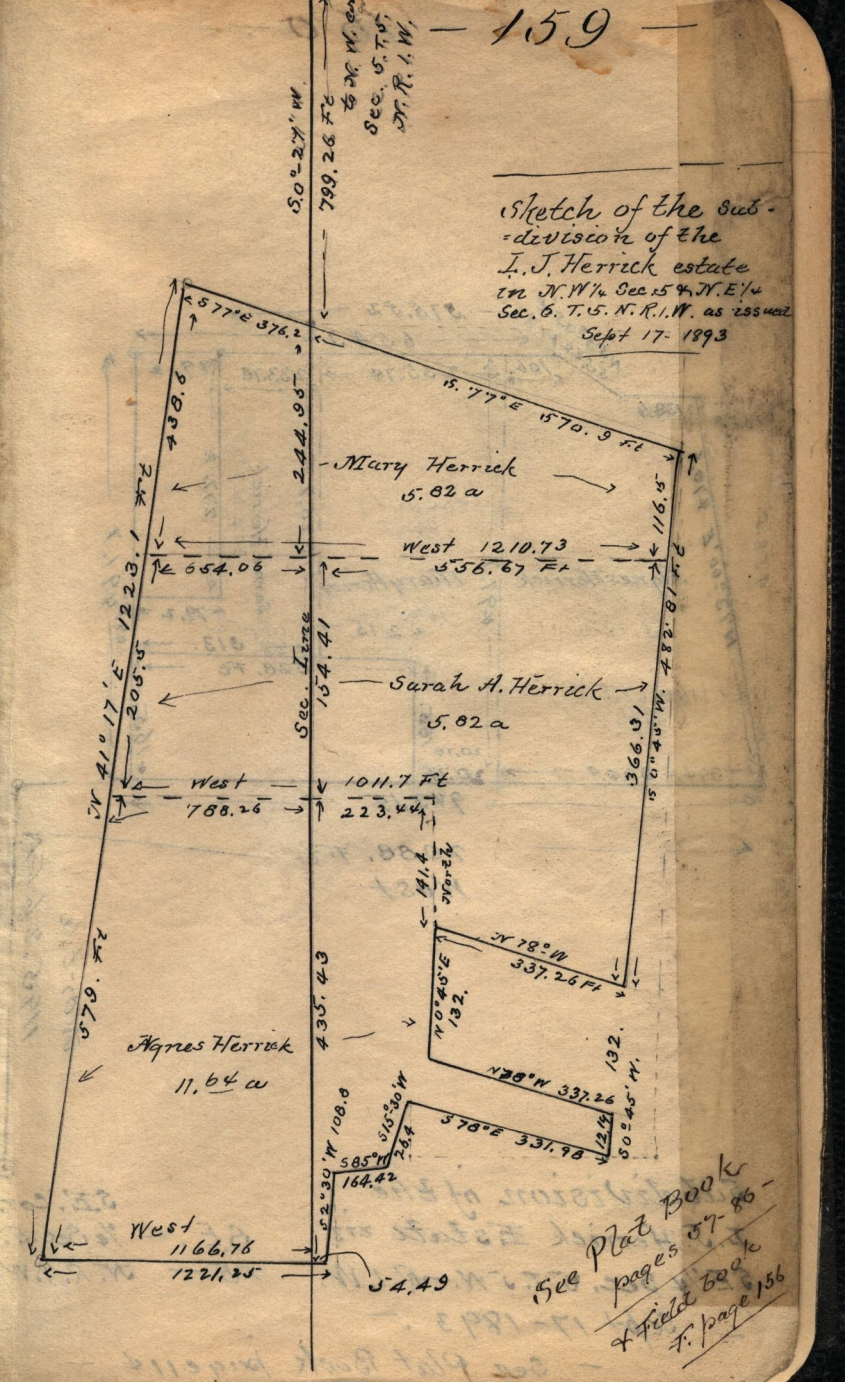


See Plat Book pages 87-86- & Field book T. page 156