January 12 - 1895.

Survey № 1. for the Oregon Lumber Comp. of Ogden.

Being the location of the West Line of the E½ of Lot 4. B 34. Plat A. Ogden City Survey according to City Monuments.

Fees. 2.50

J. Belnap Asst.

M.D. Lessenger

Survey № 2 Jan. 13 - 1895

For lawyer M.D. Lessenger of part of Lot 2. B-31. P.A. O.C.S. Beg. 138. Ft E. of S.W. cor. said Lot. E. 10. Ft N 80. Ft W. 10. Ft S 80. Ft to beg. also. Beg. 172. Ft E. of N.W. cor. said Lot. S 52. Ft. W. 10. Ft. N. 52. Ft E. 10. Ft. to beg.

Fees 5.00
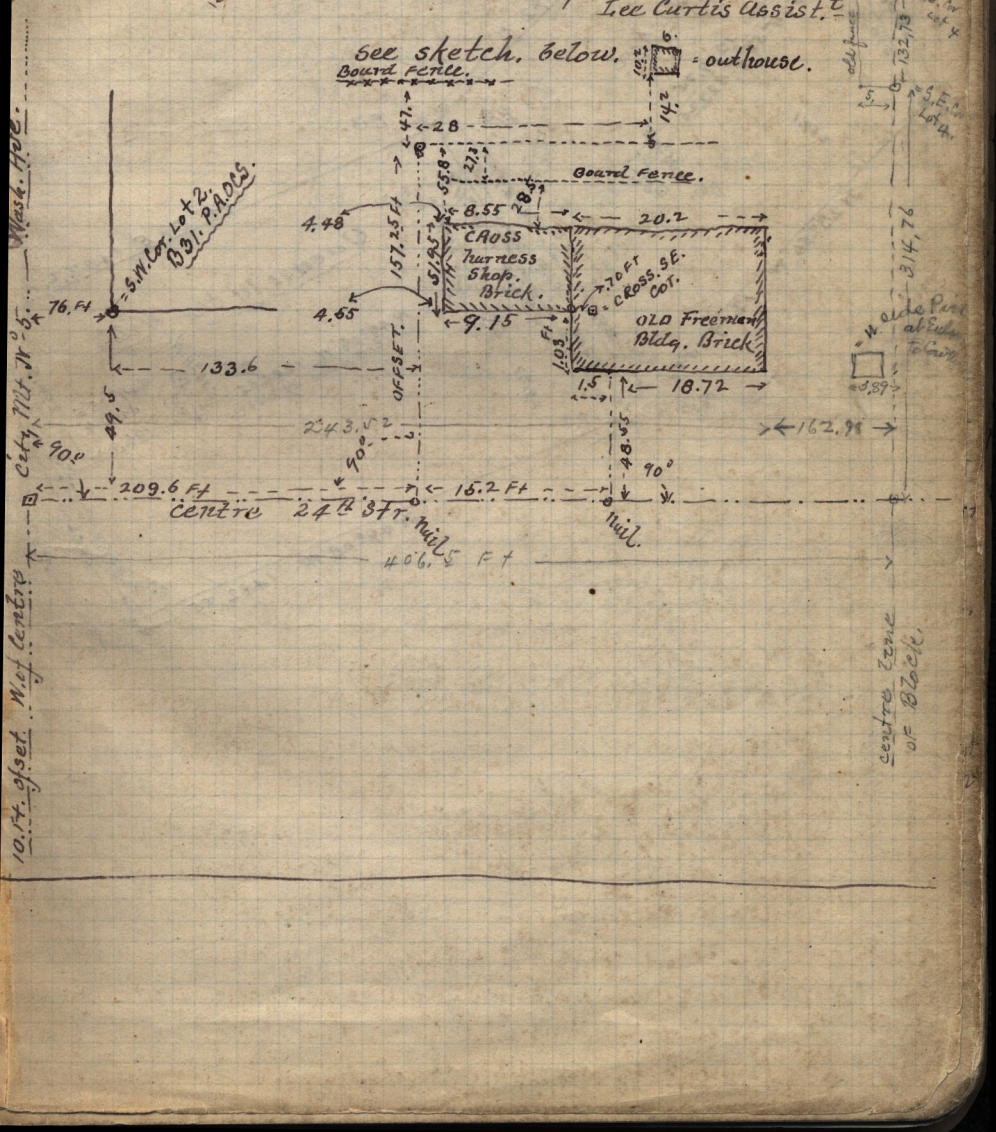
Lee Curtis Assist.