


Corrections made in the location of the lode veins of the Red Jacket & Queen of the Hills mineral Claims Survey, as U.S. Deputy mineral surveyor, by order of the U.S. Surveyor General, January 14-1894

Paradise District.

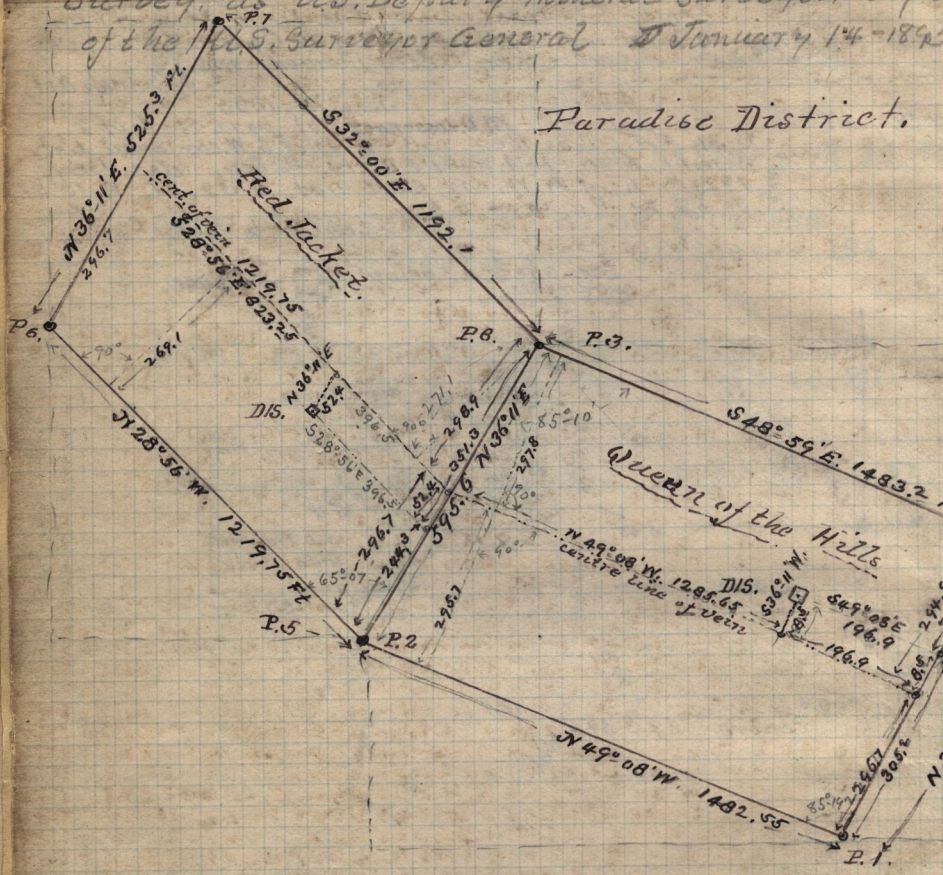

see also pages 64, 7, this book.