


Jan. 27 - 1895

*Corrections made in areas and intersections, "Queen of the Hills and Red Jacket Lode," Lot 40, Paradise Mining District, Cache Co. Utah,*

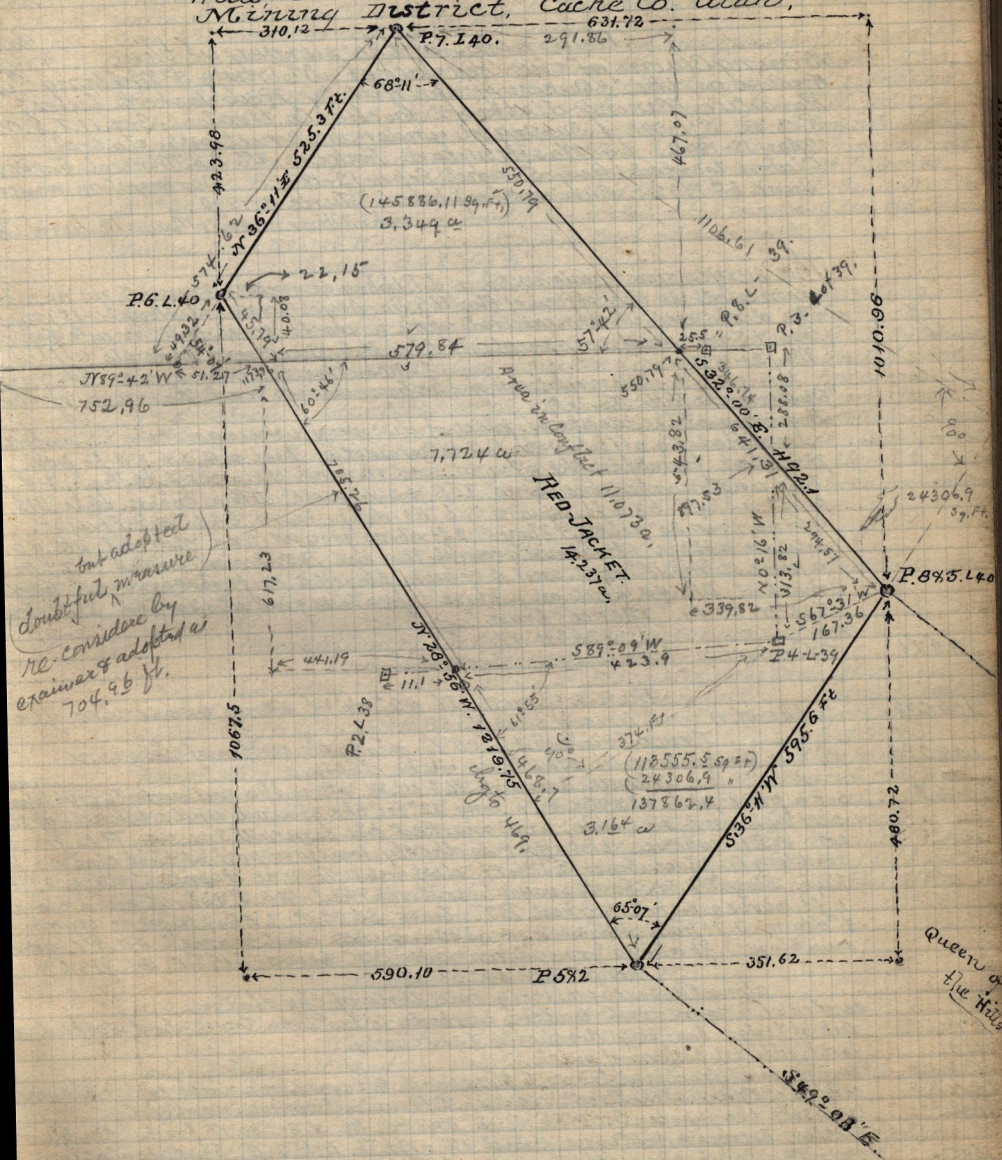

*Queen of the Hills*