Blue Creek Reservoir site & canal.

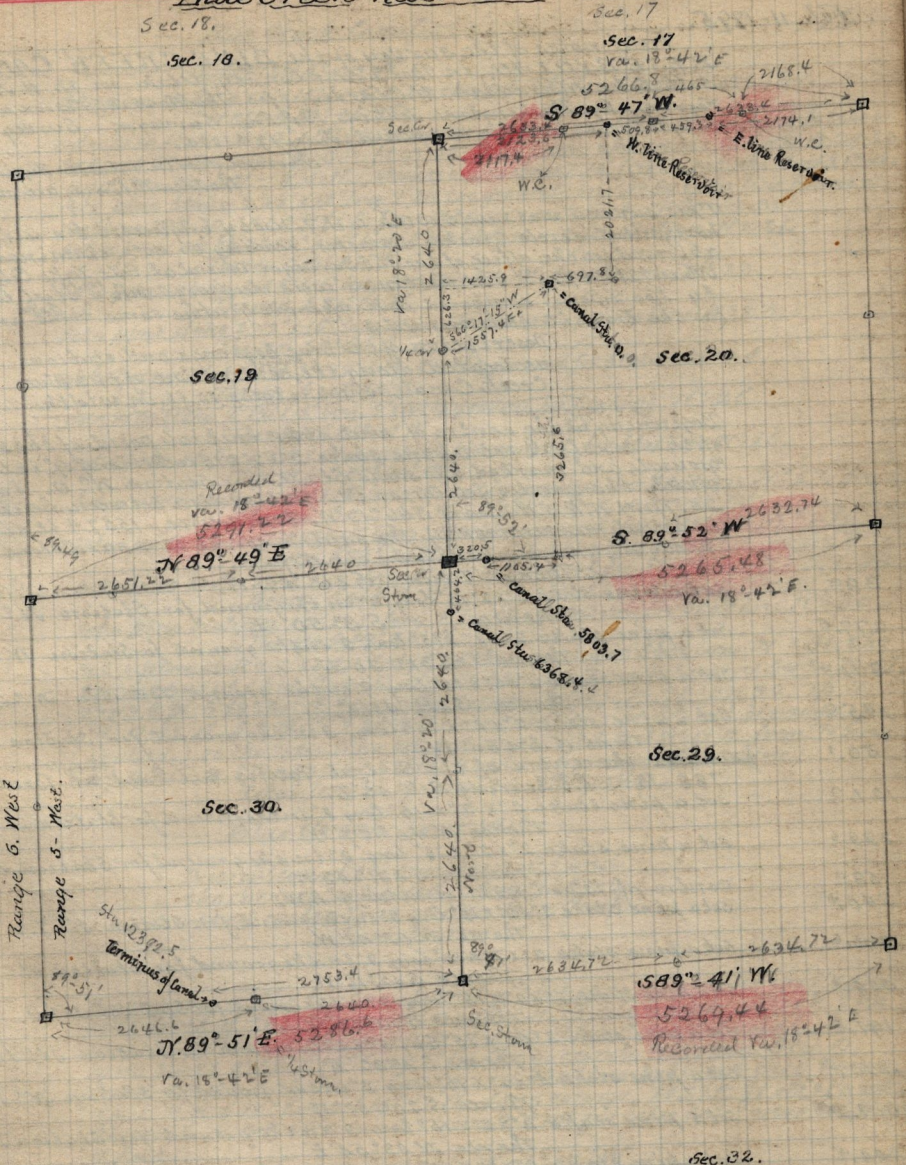

The above sketch shows the Sections through which the Blue Creek Canal and Reservoir pass in Tp. 11. North, Range 5. W.. platted according to the official survey in the U. S. Surveyor Generals office.

The survey of the above Canal and Reservoir was begun July 11- and ended July 17- 1894. See book K. pages 107. to 111. & Level Book, pages 136. to 151.