(See Field Book H. page 25)

— 21. —

Feb. 21st 1895.

ur. Joe Fife, Riv. Dale.

H-233. M.B. Child to Jos. Fife - Pt. N.W. 1/4 Sec. 7. T. 5. N - R. 1. W.
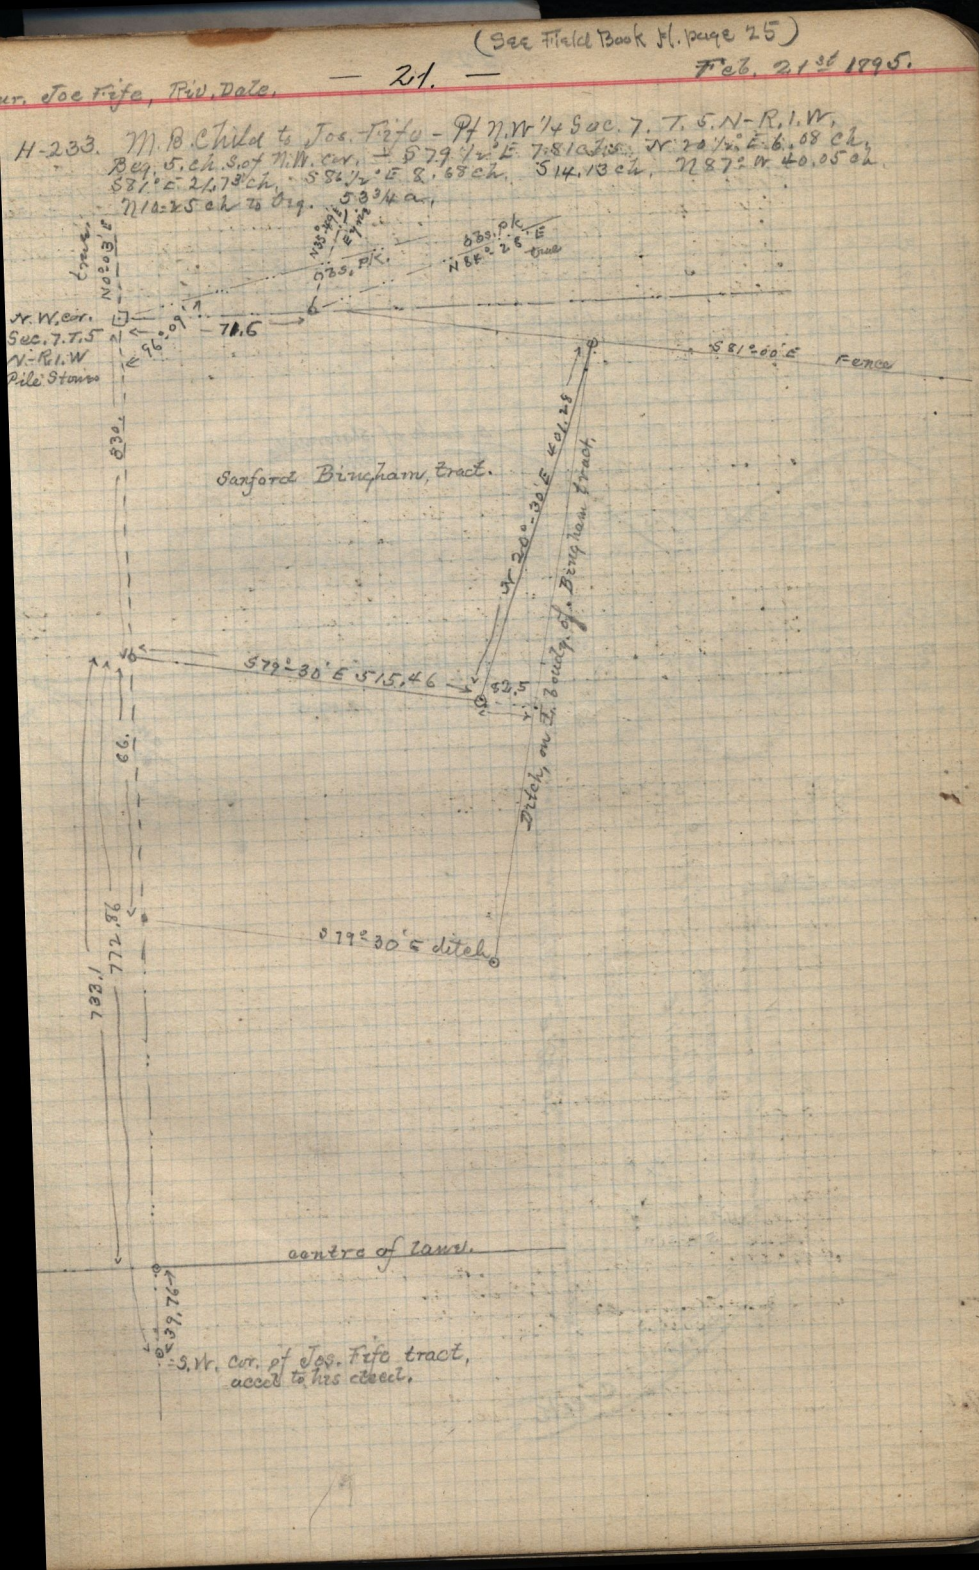
Beg. 5. ch. S. of N.W. cor. ± S 79 1/2° E 7.81 ch. S. N. 20 1/2° E. 6.08 ch. S 81° E. 2.1.78 ch. S 82 1/2° E. 8.65 ch. S 14.13 ch. N 87° W 40.05 ch. N 14.25 ch to beg. 53 3/4 a.