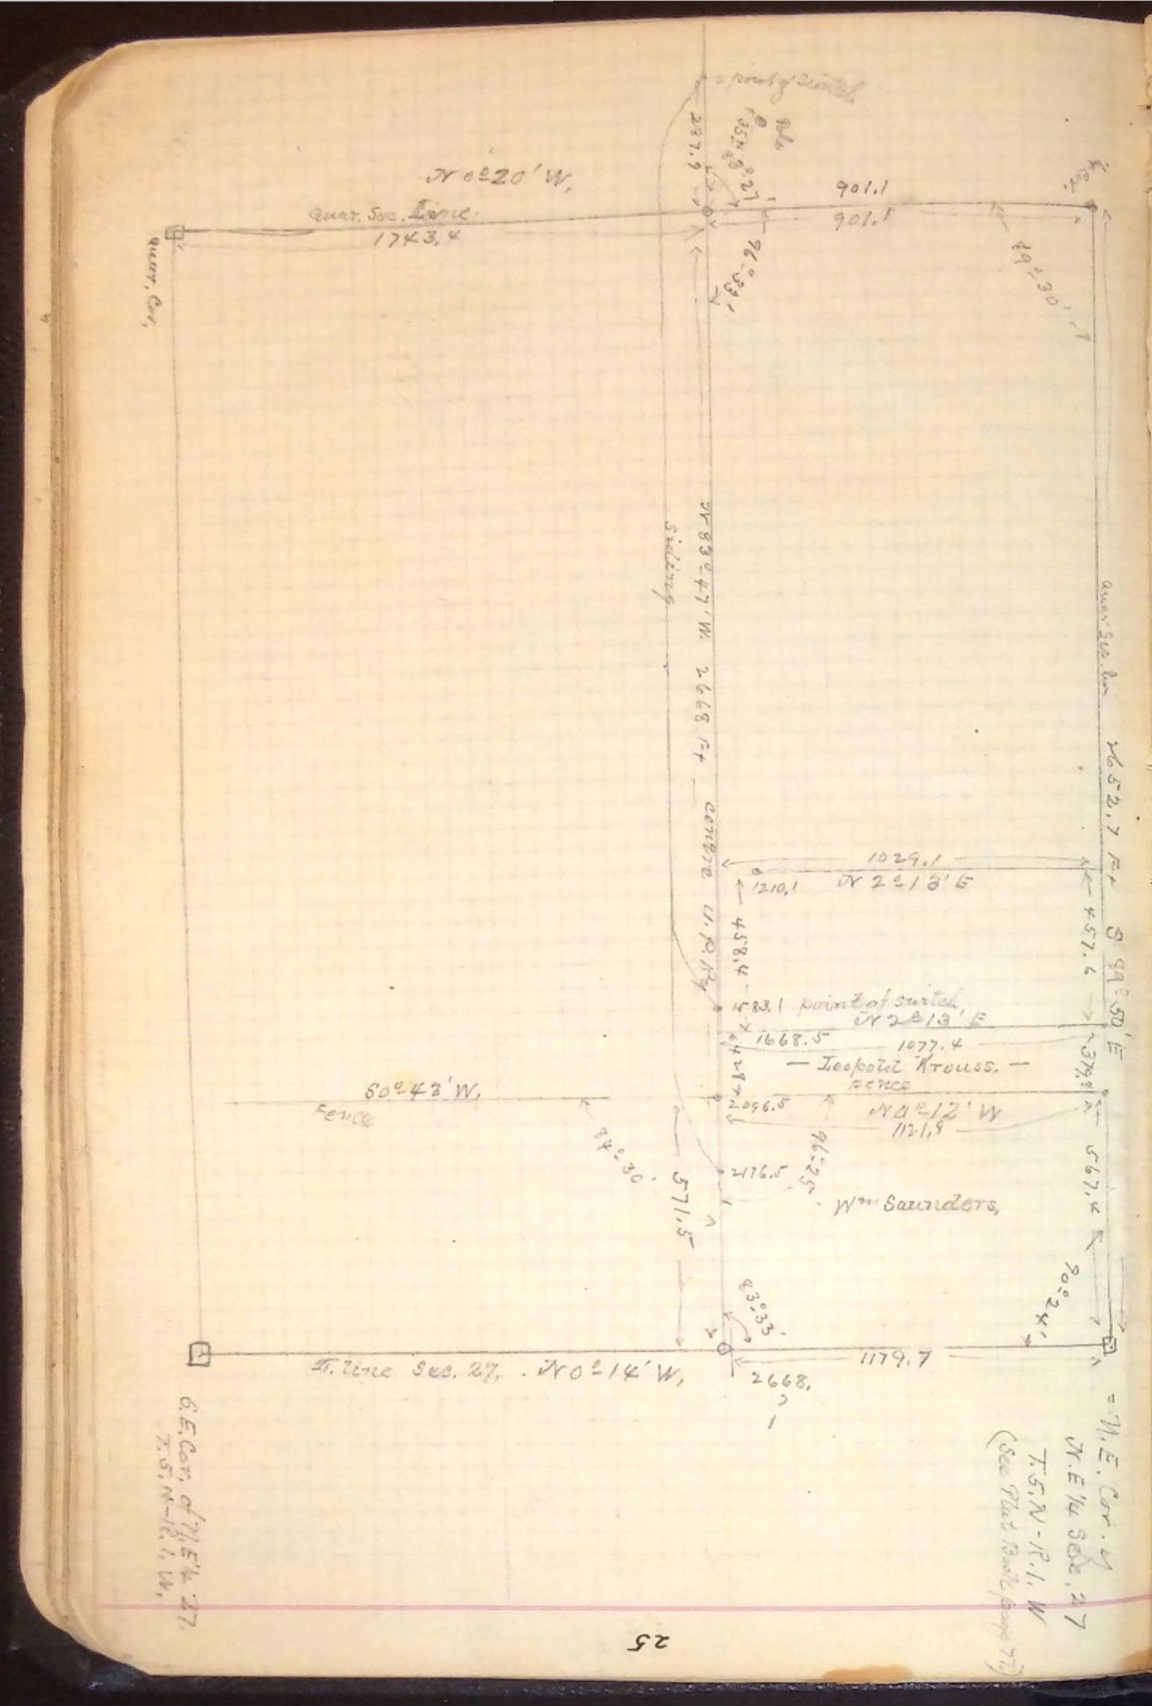
N 0° 20' W,
Quar. Sec. Line.
1743.4
Quar. Cor.
901.1
901.1
N 83° 47' W, 2668 Ft.
1029.1
N 2° 13' E
1210.1
457.4
S 89° 50' E
1583.1
N 2° 13' E
1668.5
1077.4
— Leopold Krouse. —
fence
N 0° 12' W
1121.8
S 67.4
50° 43' W,
Fence
2096.8
97° 30'
571.5
2176.5
92° 25'
Wm Saunders,
43° 33'
1179.7
2668.
N. line Sec. 27, N 0° 14' W,
N. E. Cor. of N.E.¼ Sec. 27, T. 5 N., R. 1 W.
(See Plat Book, Page 76)