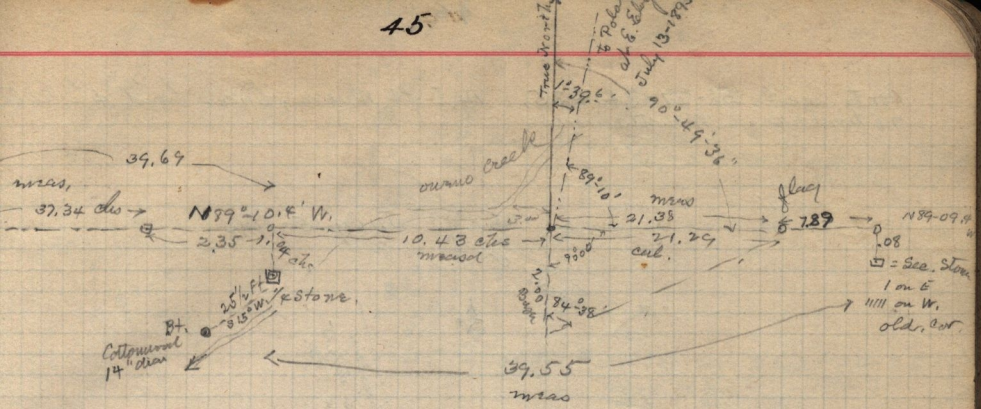

For Cor. to Secs 35 & 36. set quartzite boulder 15 X 8 X 6 10" ugrn marked 5 grooves on W. & 1 groove on E with mound of stone on N. the old Cor. to Secs 1-2-35 & 36 which is bears 1.90 chs E.

For. ¼ cor. on S. line Sec. 36. set quartzite boulder 14 X 10 X 4 - 10" in ground marked ¼ on N. face mound of stone on N.

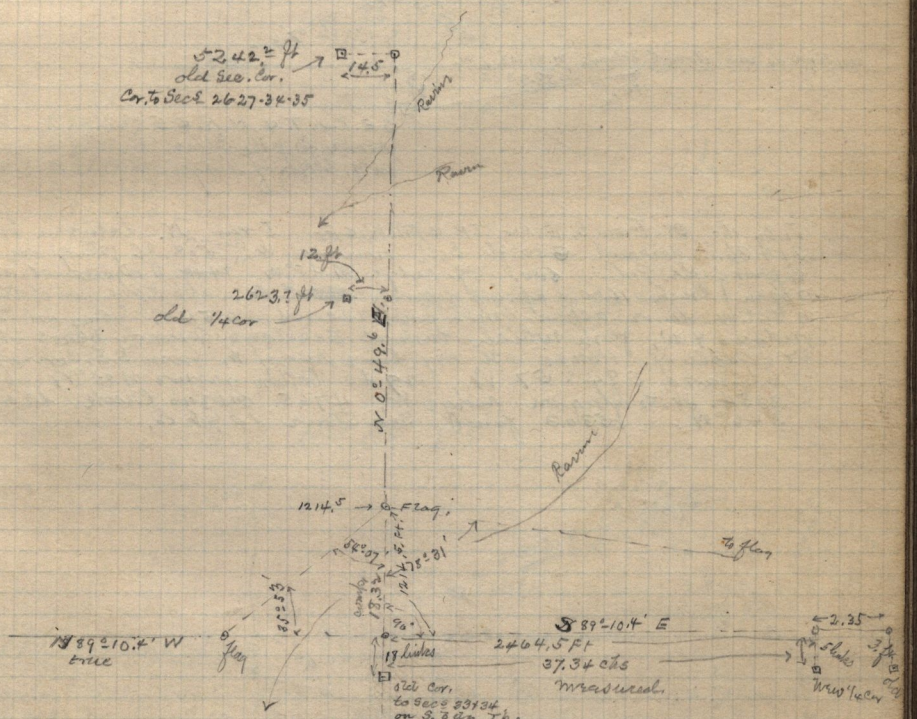

N. 0°-49.6' W on random line bet Secs 34 & 35. leg. at point 18 links N. of Cor. to said Secs 500. ft top of bluff 700. bott. of ravine S 80° W 150 ft deep 400 feet wide 1100. top of bluff 2623.7 ft to find old ¼ Sec. Stone 12. ft W. a quartzite boulder 11 X 10 X 8 firmly in ground & marked ¼ on W. face thence ascending. rough ground 3600 ft ridge bears S 50° W. 4000. ft bottom of ravine 50 ft deep 600 ft wide bears S 80° W. 4604. bottom of ravine 50 ft deep 200. ft over bears S 30° W. 5242.2 ft to find old Sec. Cor firmly in ground 21 X 12 X 12 boulder