






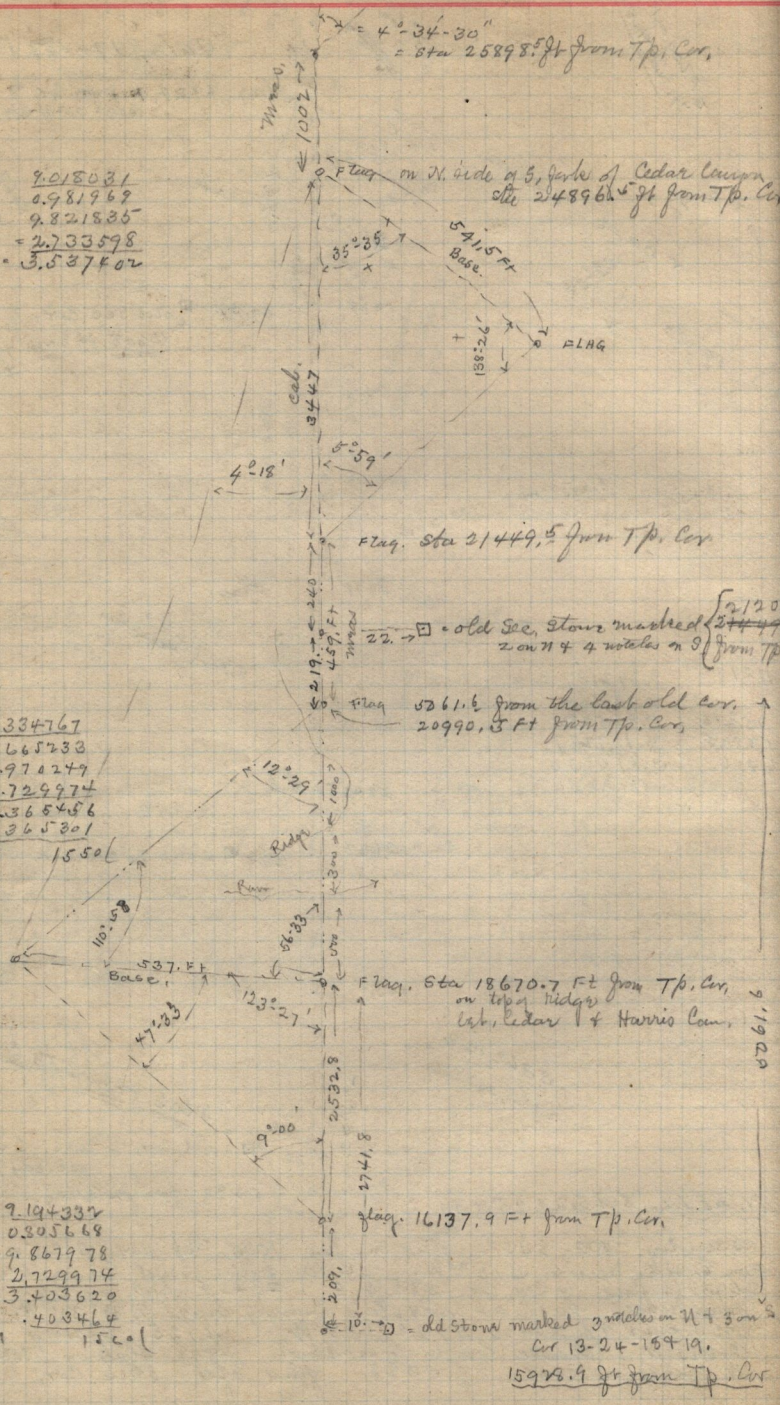


5761.6

15923.9 ft from Tp. Cor.