

Course of E. bdy
N. 0° 09' E.

$\sin 13^{\circ} 31' 30'' = 9.368973$
 $\cos 65^{\circ} 00' 30'' = 0.631027$
 $\sin 65^{\circ} 00' 30'' = 9.957305$
 $\log 1296.6 = 3.112816$
 $5025.1 = 3.701148$
701136
 86 120(

$\sin 4^{\circ} 34' 30'' = 8.901806$
 $\cos 73^{\circ} 57' 30'' = 1.098194$
 $\sin 73^{\circ} 57' 30'' = 9.982751$
 $\log 416.9 = 2.620032$
 $5023 = 3.700967$

$\sin 6^{\circ} 07' = 9.027567$
 $\cos 91^{\circ} 43' = 0.972433$
 $\sin 91^{\circ} 43' = 9.999805$
 $\log 236.1 = 2.373096$
 $2215 = 3.345334$


Sec. 1

Sec. 6

Sec. 12

Sec. 7

$\sin 14^{\circ} 53' = 9.409682$
 $\cos 63^{\circ} 39' = 0.590318$
 $\log 1296.6 = 3.112816$
 $4524 \rightarrow 3.655490$
7584
 53124
 5280
324
 53121
 85
 5214
 5124

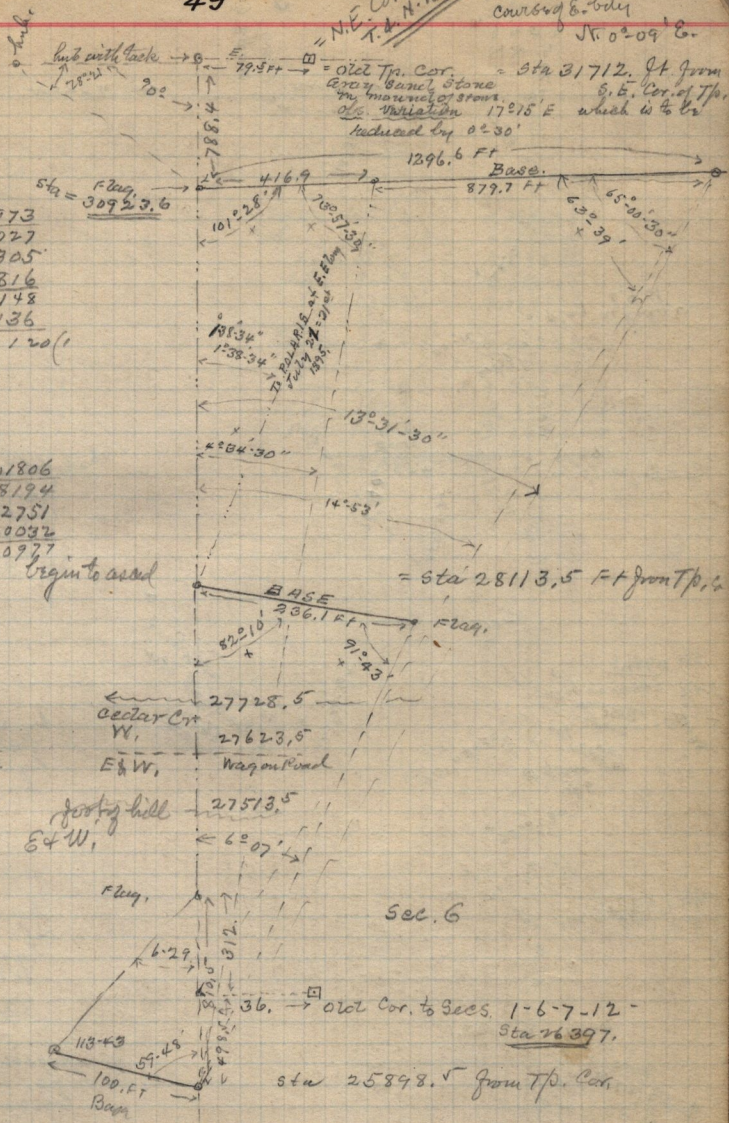

old Cor. to Secs. 1-6-7-12
Sta 26397.
 sta 25898.5 from T.P. Cor.