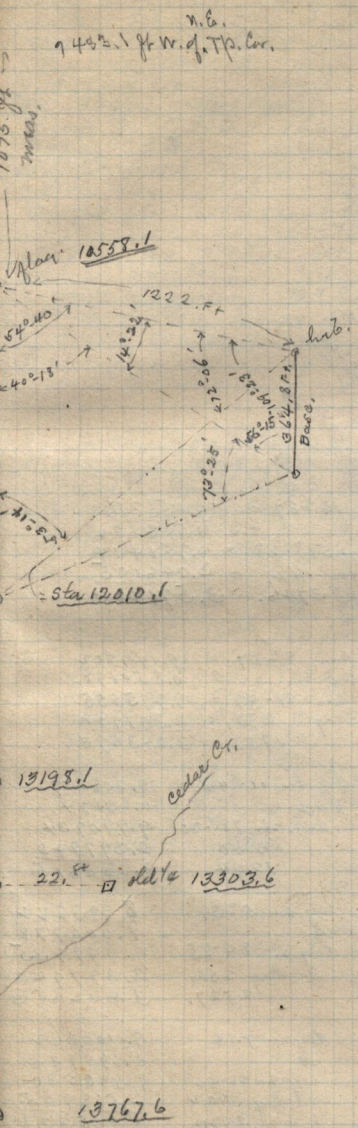

log. sin	14°-22'	=	9.394673
ac		=	0.605327
log sin	56°-15'	=	9.919846
log	364.8	=	2.562055
	1222.		3.087228

log sin	53°-14'	=	9.903676
ac.		=	0.096324
log	72°-06'	=	9.978452
log	1222.	=	3.087228
	1452.		3.162004