


Standard 14 Cor. on S. line Sec. 31. T. 5. N. R. 4 E  
 quartzite stone 16 x 12 x 6. 12 in. long  
 marked S.C. 14 on W. face top of stone  
 on N.

2117.5 ft → W. along S. line Sec. 33 T. 4. N. R. 4 E  
 2077.5 → hub, west of riparian road, 2662.5 ft  
 at Sta 2117.5 ft offset 250 feet North to avoid brush  
 and then continued my line West  
 at 5324.91 ft offset S. 250 ft and find old Sec. Cor. 7.5 ft S  
 since I ran W. on line parallel 7.5 ft N. of Cor. to Sta 324

W. along S. line Sec. 32.  
 26-60 do not find 14 cor. 4000 ft begin to ascend hill  
 5332. find Cor. Stone, Cor. to Sec. 31432. a boulder  
 stone 1 notch on W. & 5 on E, 16. feet S. of my line,

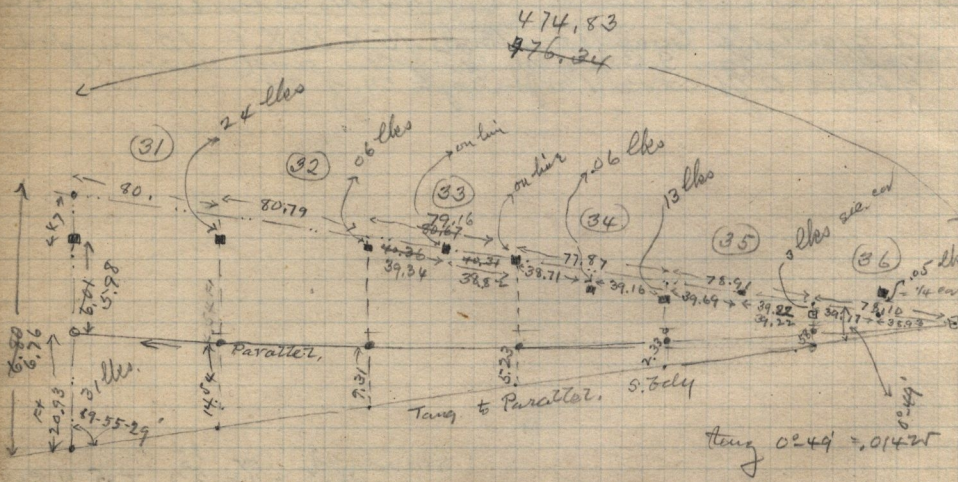

- S. Body Sp. -

{ at 38.93 ch I find 14 cor. 60 lles N. } S. line 36  
 " 78.10 " " Sec. Cor. 107 lles N. }  
 at 39.22 ch I find 14 cor. 165 ch N. } S. line Sec 35  
 " 78.91 " " Sec. Cor. 2107.4 N. }  
 S. line 34. ) at 39.16 find 14 cor. 2168 ch N. at 77.87 find Sec cor. 3.2