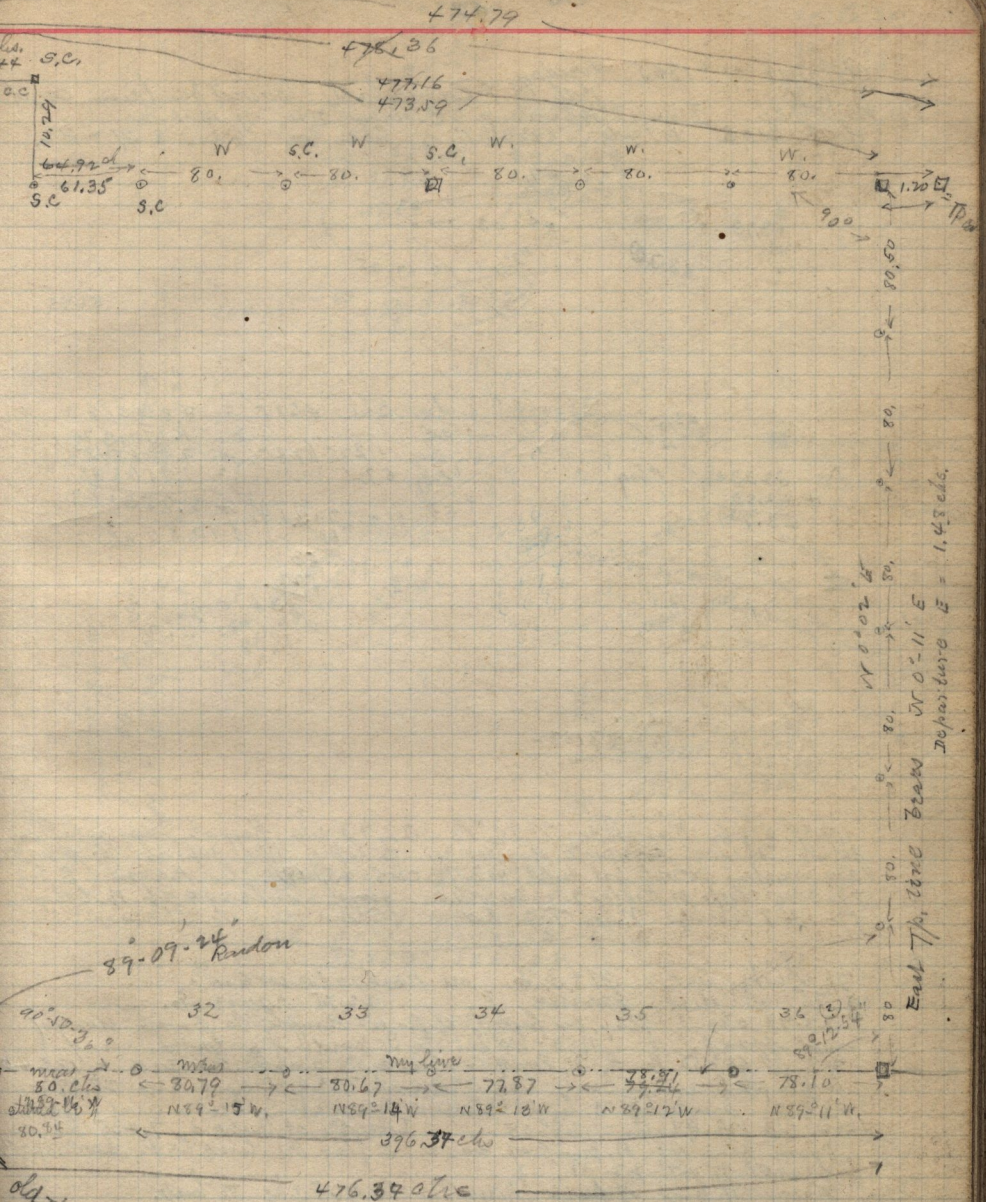

S. line Sec. 33, at ~~40.31~~ 38.82 chs find 1/4 cor. 3.81 chs N. at ~~80.67~~ 79.16 chs Sec. cor. 4.29 chs N.
S. line Sec 32, " 40. do not find 1/4 cor 80.79 ch sec. cor 5.19 chs N.
S. line Sec 31, 80. chs find S.W. Cor. Tp. 6.01 chs N.

line bet.	Sec. 31 & 36.	W. bdy	81.21	ch.
" "	" 25 & 30	" "	79.68	"
" "	" 19 - 24	" "	79.60	"
" "	" 13 - 18	" "	82.00	"
" "	" 7 - 12	" "	81.36	"
" "	" 1 - 6	" "	83.19	
			487.04	

Course of S. bdy from S.E. cor Tp. to S.W. cor. of Tp. N89°-17' W. and the distance is 476.34 chs. and not as stated by S.G.