



N 0°-10'-24" W

*this point is wrong  
or 2.3 chains  
marker at 2.71 chs  
Sof Sec. Cor.*

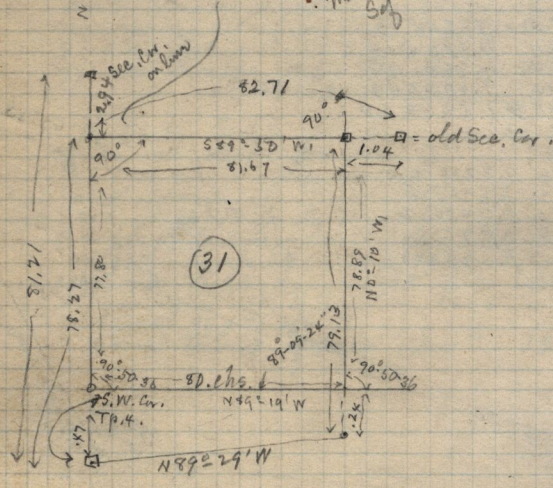

tag 02-41' = 0119  
80  
9520

Tag 02-10 = 0029  
80  
2320 110

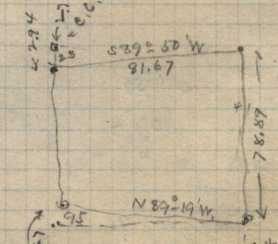

*E. Side 31, should be  
78.87 chs*

81.21  
78.27  
77.13  
76.89  
78.87  
78.41