


Monday Aug. 12-1895
 N 0°-10'24" W. on Randolph blank line
 leg. at S. W. Cor. T. 4. N. R. 4 E.

From point 1.46 chs. N. of the Cor. to Secs. 13-15-19-24 on N. edge
 of Tp. 12n 70°-10'24" W. on blank, at 40.77 chs. incl 14
 of Cor. 1.63 chs. E. 1/4 Cor. is situated 3 chs. N. of Spruce, and
 10. chs. N. of bottom of ravine S 70° W. bottom of ravine
 is 338° W. 82.03 chs. find Cor. to Secs 7-12-13-18 } 1.82 chs
 blue quartzite. Stone firmly set. 2 grooves N. 4 S. mid stone
 N. - N. 0°-10'-24" W. on random blank line from point 1.82 chs
 W. of Cor. to Secs 7-12-13-18. W. edge. 40.57 chs find 40 Cor. 1.95 E
 bottom ravine N 35° E. 70.03' top of ridge N 45° E. ←

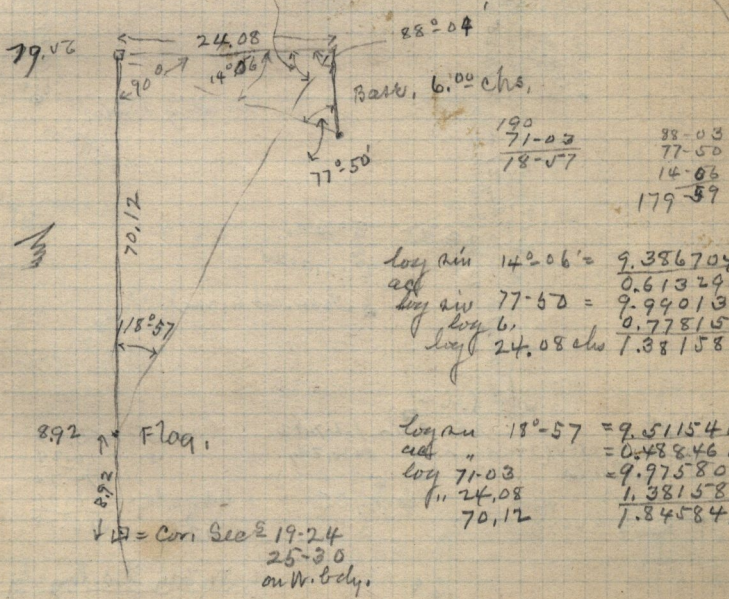

81.36 chs. find Cor. to Secs 1-6-7-12. 1.95 chs E. which is
 a boulder stone 12 X 10 X 8 firmly set, marked and intrusted
 mound of stone N. as described by the surveyor.
 From point 1.95 chs. N. of Cor. to Secs 1-6-7-12
 N. edge, rand 70°-10'24" W. on blank line 40.73 chs incl 14
 Cor. 2.16 chs E.