

Thursday, Aug 15-1895

E. on Random line Cont 25436
 ascending 20. chs ^{60.88} S 10° W
 25436


Shadows

80, 10 ch. intersect E. ldy, 25 miles N. of Cox,
 W. on true line Cont 25436
 ascending.

40.05 chs. det boulder Sta
 12 X 8 X 8, 9" mag ground for
 mid stone.

Sec. 25

Sec. 25

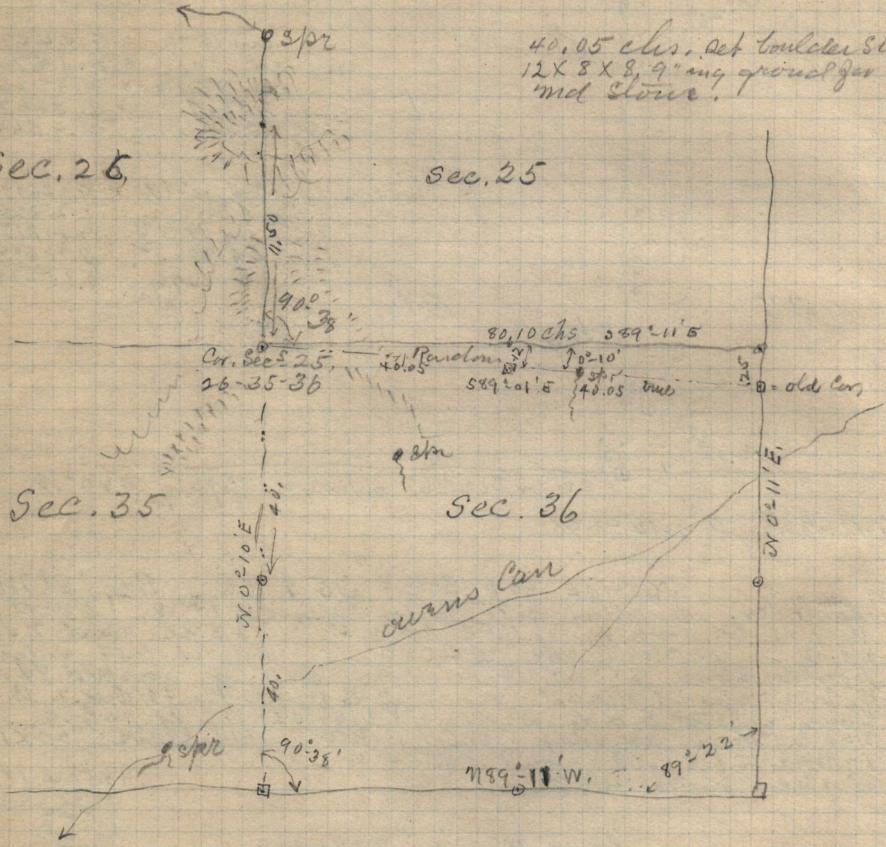

Sec. 35

Sec. 36


