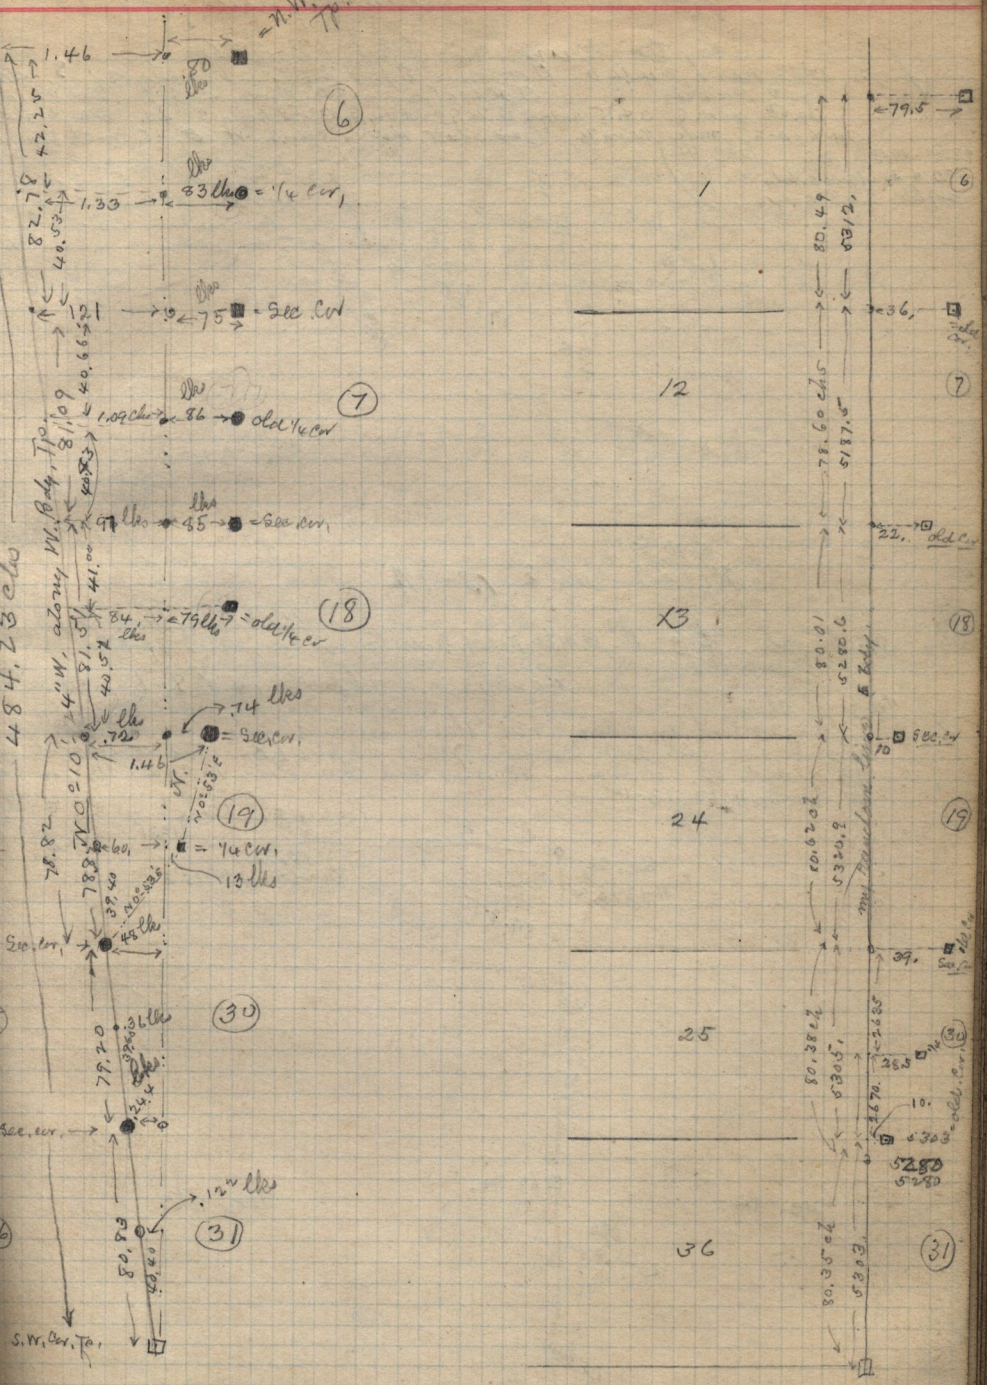

tang 0°-10'-24" = 0.00302

Re-trace W. Bdy