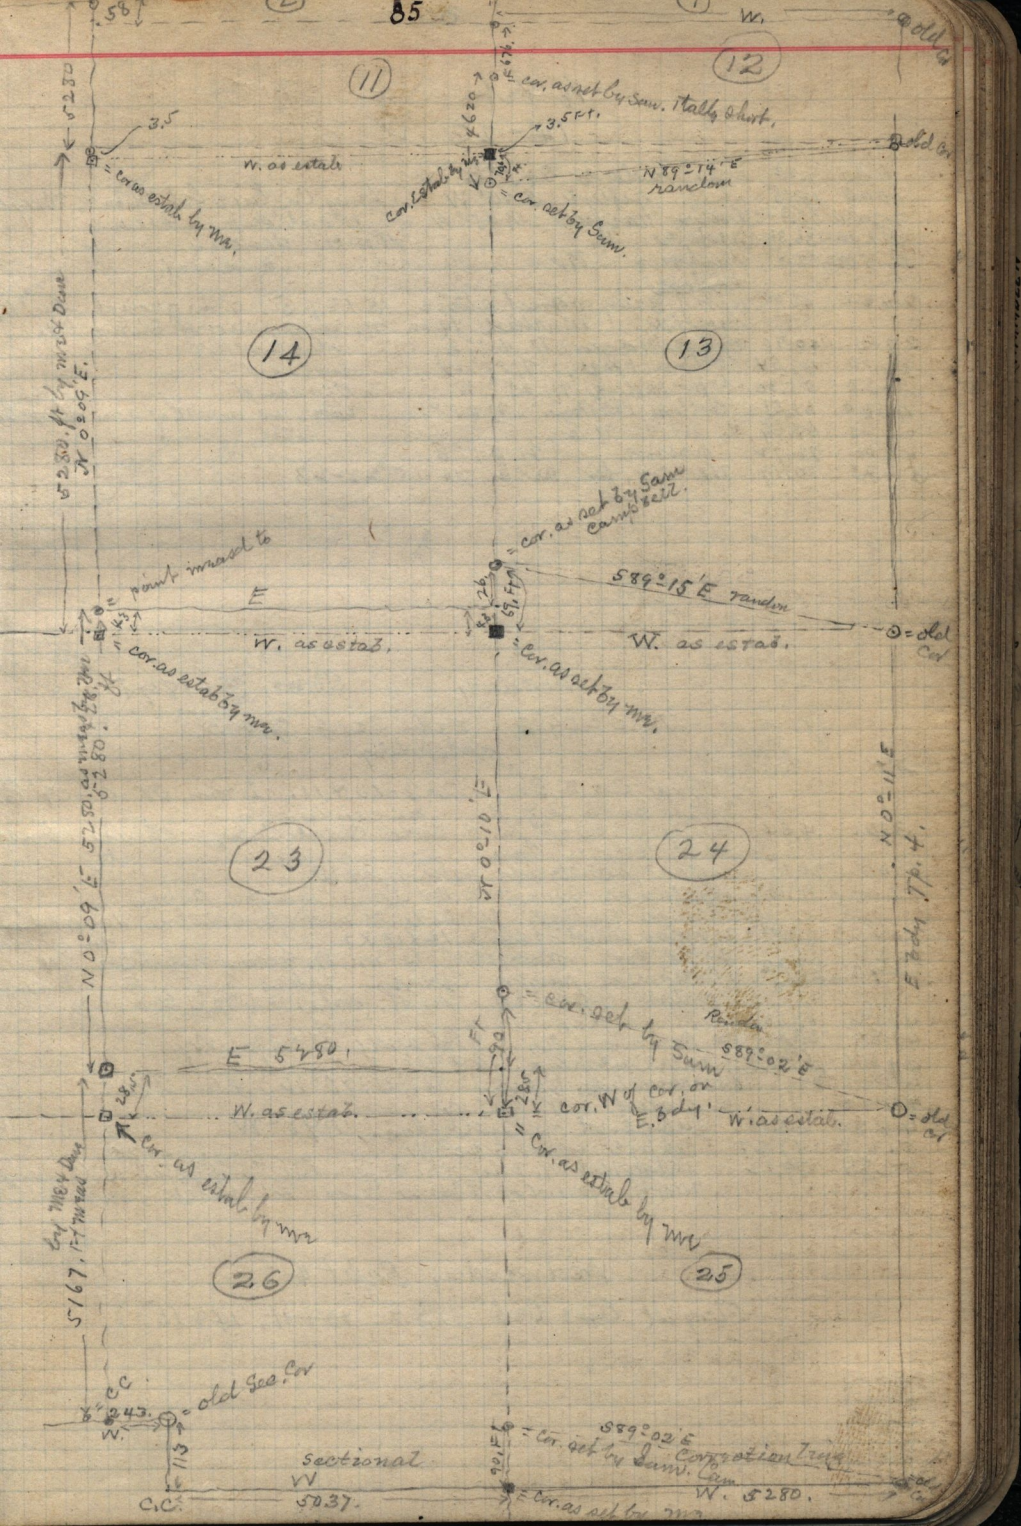

58
W.
old Cor
(11)
(12)
5280
3.5
= cor. as set by Sam. Itally short.
4620
3.5 Ft.
W. as estab.
= cor. as estab. by Mr.
cor. estab. by Mr.
= cor. set by Sam.
N 89°14' E random
old Cor
(14)
(13)
5280. ft by Mr & Dam
N 0°09' E.
= cor. as set by Sam Campbell.
= point measd to
E
S 89°15' E random
W. as estab.
= cor. as estab by Mr.
= cor. as set by Mr.
= old Cor
(23)
(24)
N 0°09' E 5280. as meas by Mr 5280. ft
N 0°10' E
N 0°11' E
E bdy Tp. 4.
= cor. set by Sam
Random
S 89°02' E
E 5280.
W. as estab.
cor. W of cor. on E. bdy.
W. as estab.
= old Cor
= Cor. as estab by Mr
= Cor. as estab by Mr
(26)
(25)
5167. ft meas by Mr & Dam
C.C.
= old Sec. Cor
243.
W.
113
Sectional
W
5037.
C.C.
S 89°02' E
= Cor. set by Sam. Cam.
Correction Line
W. 5280.
= Cor. as set by Mr.