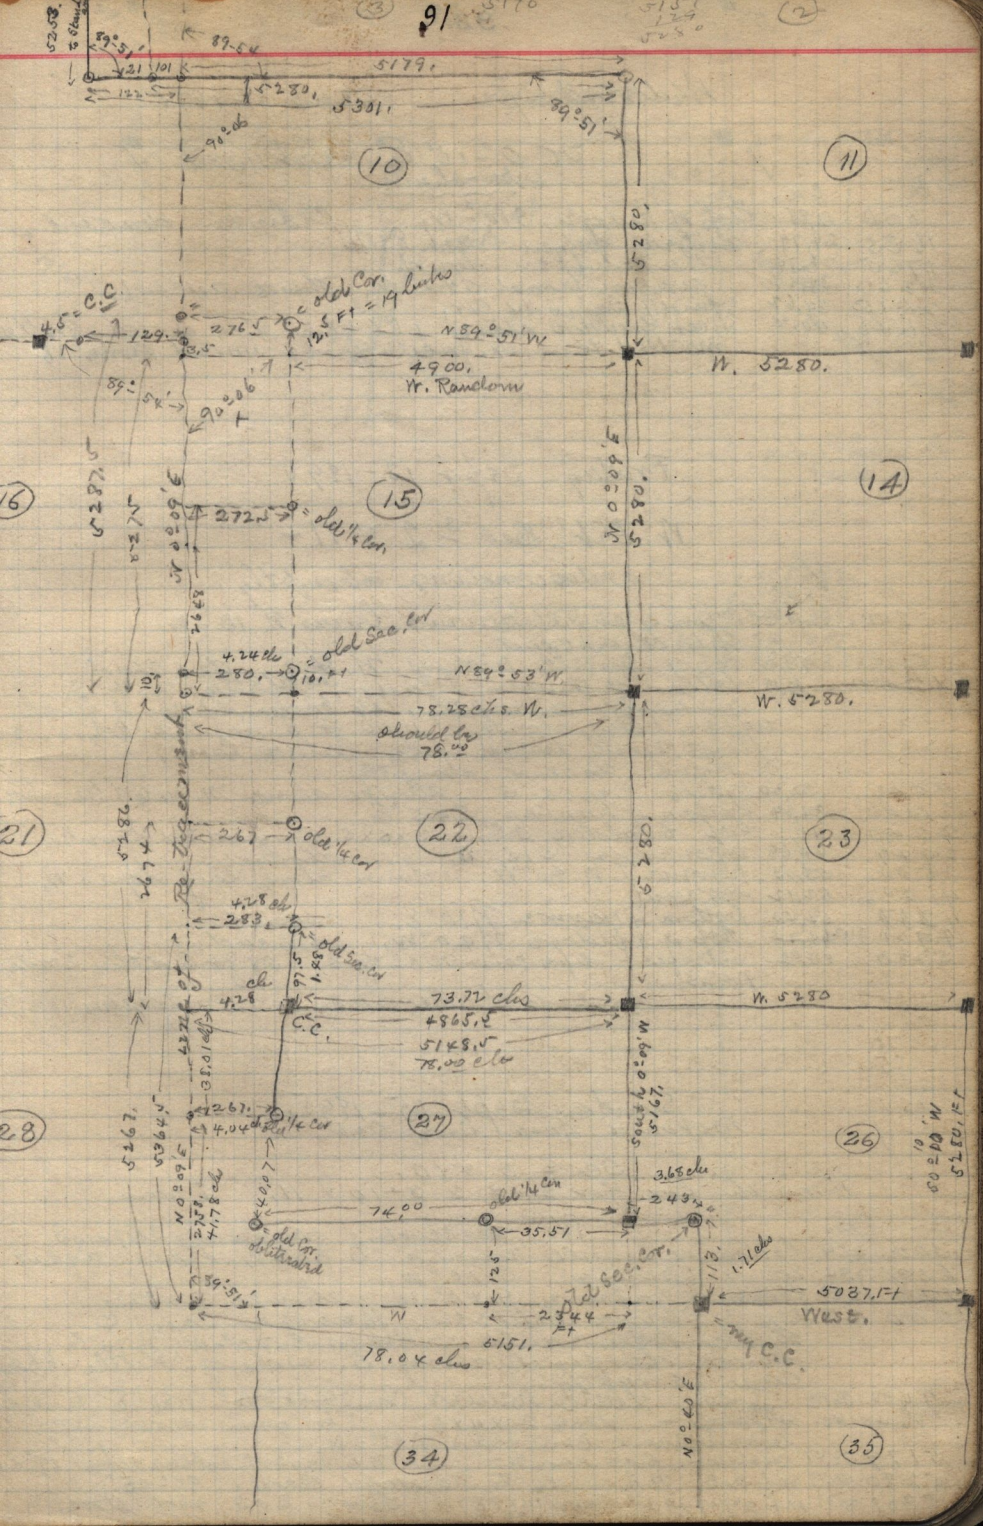
10
11
14
15
16
21
22
23
26
27
28
34
35
C.C.
old Cor.
19 links
N 89° 51' W
5280.
W. 5280.
4900.
W. Random
N 0° 09' E
2640.
2720
= old 1/4 Cor.
= old Sec. Cor.
4.24 chs
280.
N 89° 53' W
78.28 chs. W.
should be
78.00
W. 5280.
2672
old 1/4 Cor.
4.28 chs
283.
73.77 chs
4865.5
5148.5
78.00 chs
W. 5280
4.28
ch
C.C.
2640
4.04 chs
old 1/4 Cor.
N 89° 54' W
2644
74.00
35.51
3.68 chs
243
old 1/4 Cor.
old Cor. obliterated
N 0° 09' E
2715.
4.178 chs
S 89° 51' E
2644
78.04 chs
6151.
old Sec. Cor.
5027.1 ft
West.
1.71 chs
N 0° 09' E
5280.
S 0° 09' W
5280.
S 89° 51' E
5179.
5301.
5280.
N 0° 09' E
2640.
S 0° 09' W
2640.