


Sept 13 - 1885.

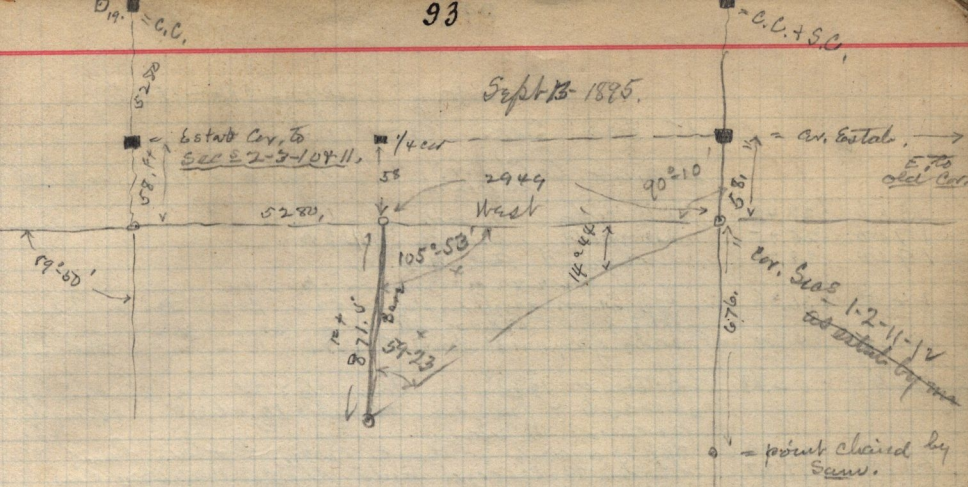

sin 14.44 =	9.405382
cos	0.9794618
sin 59.23 =	9.934798
log 871.5 =	2.940267
2949.	3.469683
2640	
309.	