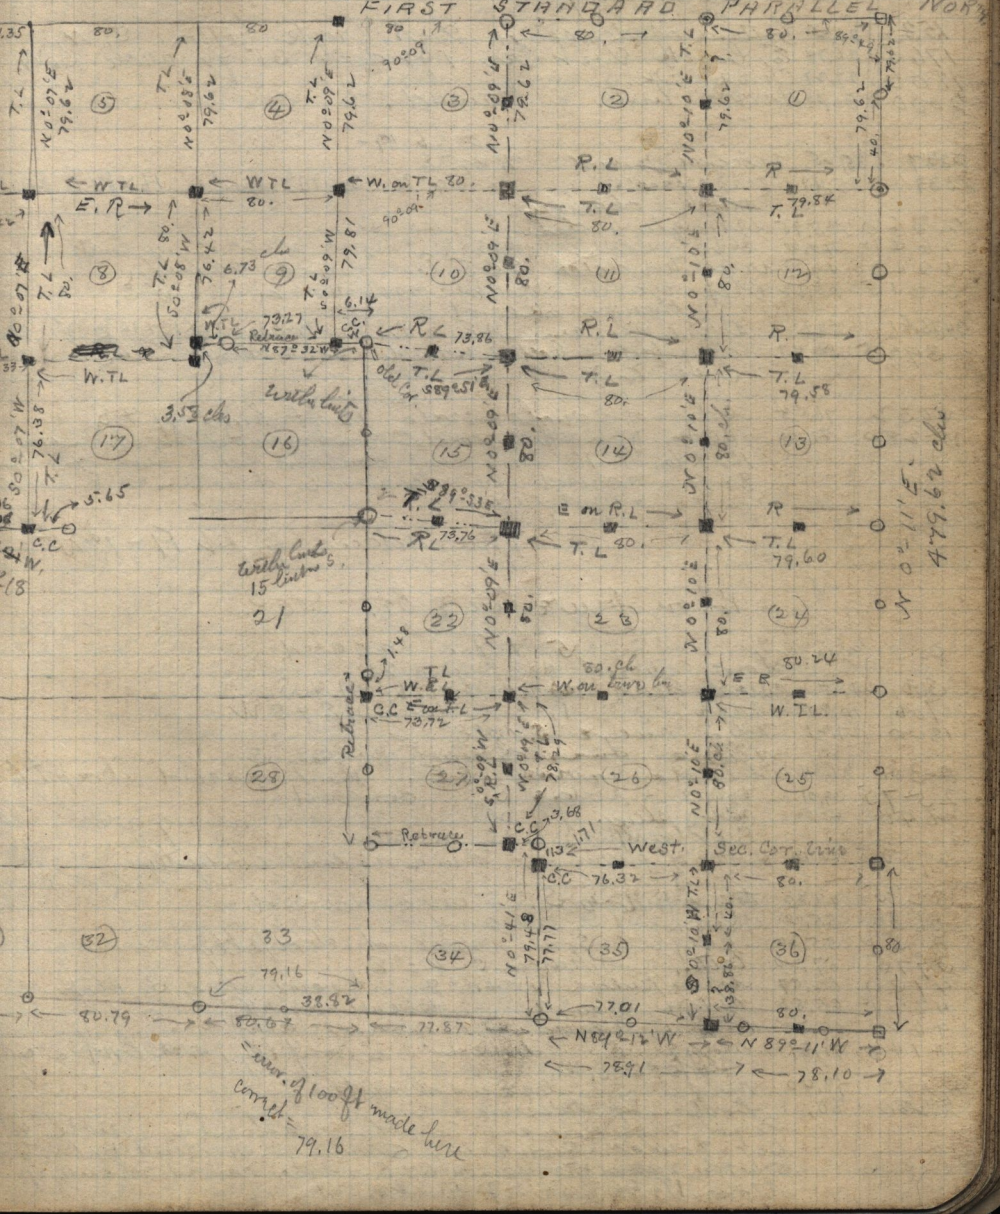
FIRST STANDARD PARALLEL
WTL
W.on TL
R.L
T.L
E on R.L
W.on Line
Retrace
West. Sec. Cor. Trim
N 89°-11' W
78.91
78.10
77.87
80.79
80.67
77.01
39.52
79.16
Error of 100 ft made here
Correct
79.16