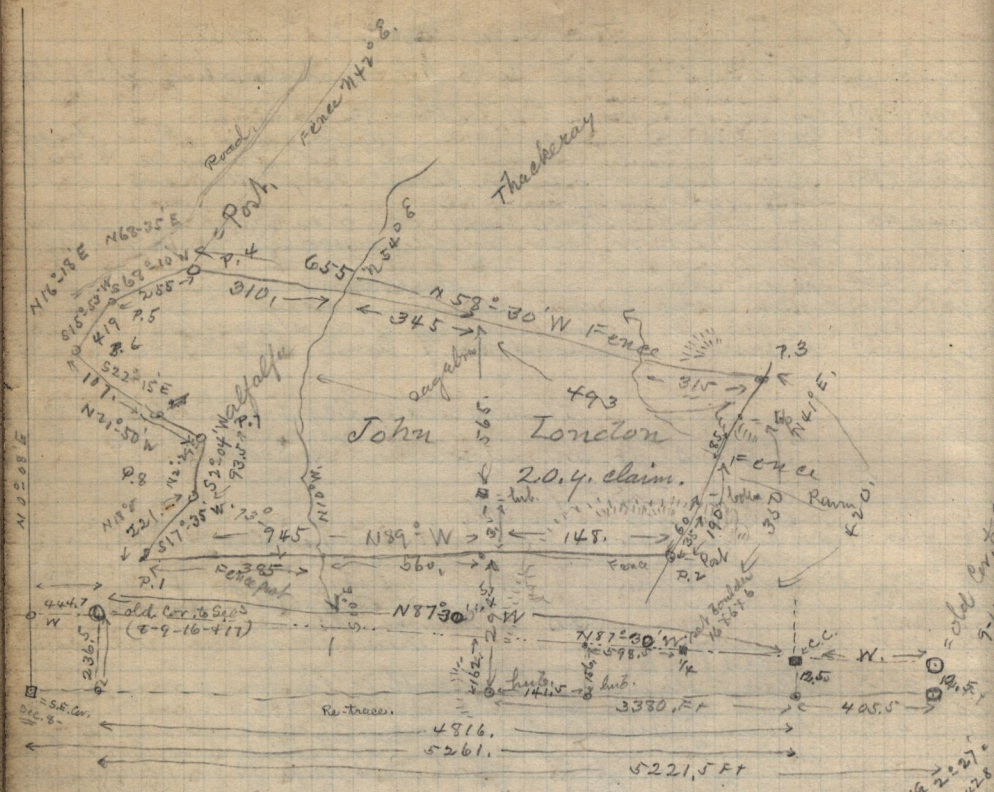

Wednesday & Thursday Sept 25th & 26 Sept 1895.

Meanders of John Londons Claim, in Sec 9,

Beg. at Post No. 1, S.W. cor. of said claim in cor. of wire fence thence I ran

S 89° E. along wire fence on S. side of said claim ascending and on S. side of alfalfa field

385.	5.83	centre of Irrigating ditch 2½ ft deep 8 ft wide S. thence leave alfalfa field, along S. side of unbro land.
945.	14.31	begin to ascend hill
1000.	15.15	top of hill
1093.	16.56	S.E. Cor. of Londons claim which is an aspen pos in wire fence. I mark same J. L. & N. W. f thence I ran N 41° E.

along the East side of claim

		descending
35	.53	begin to ascend abruptly
60	.90	foot of descent.
190	2.88	ravine or wash 10 ft deep 30 ft wide. N 20° W.
275	4.16	begin ascend.
350	5.30	top of ascent
420.	6.36	Post 3. the N. E. cor. of this claim.

Thence I ran N 58°-30' W.
along the N. line of this claim, descend

315.	4.77	ravine or wash N.
1038	12.70	centre of canal N 54° E & S 54° W.