


Meanders of John Hopkins Claim  
N. of Cedar

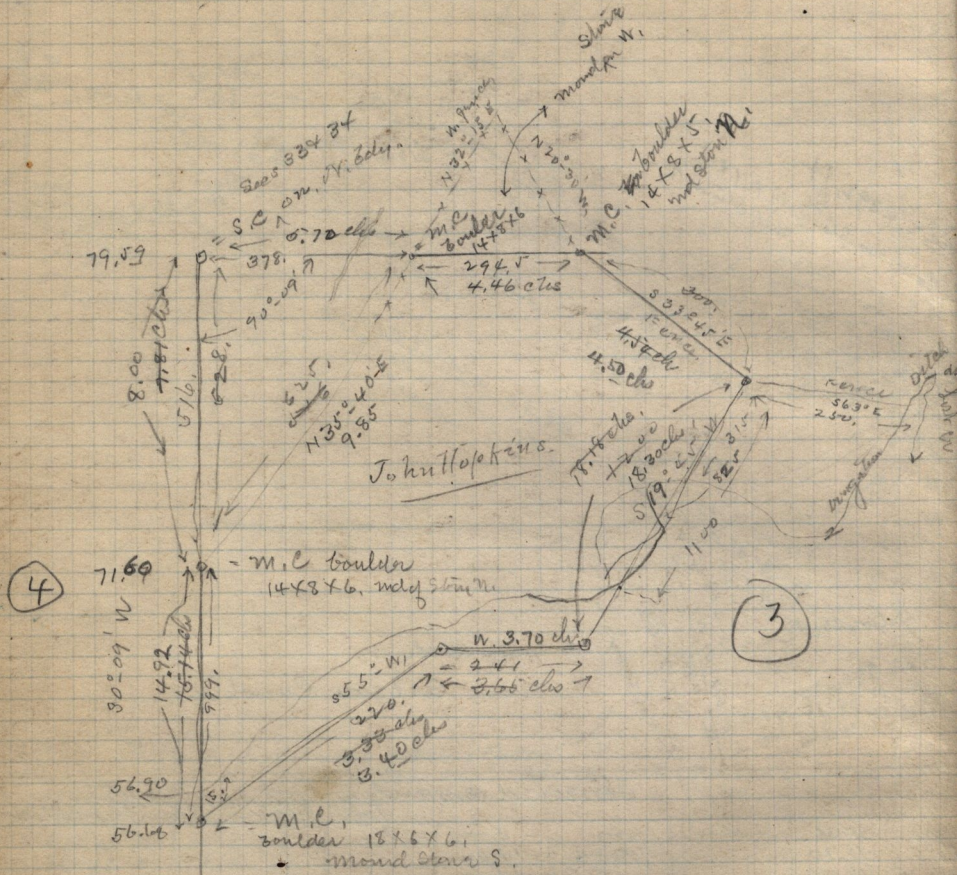

The above tract with other lands was purchased from John Caste by John Hopkins conveyed by deed duly returned & acknowledged dated April 29-1881.  
Recorded May 13-1881. in Book B. of Deeds, Morgan Co. Records

Corrected Meanders of John Hopkins's Claim on Lost Creek Cotton

	N	S	E	W
N 55° E	3.40	1.95	2.79	
E	3.70		3.70	
N 49 3/4° E	18.30	17.22	6.18	
N 33 3/4° W.	4.50	3.74		2.49
W	4.46			4.46
S 35 1/2° W	9.80		7.99	5.69
S 0° 09' W.	14.92	14.92		
	22.91	22.91	12.57	12.64

see page 169