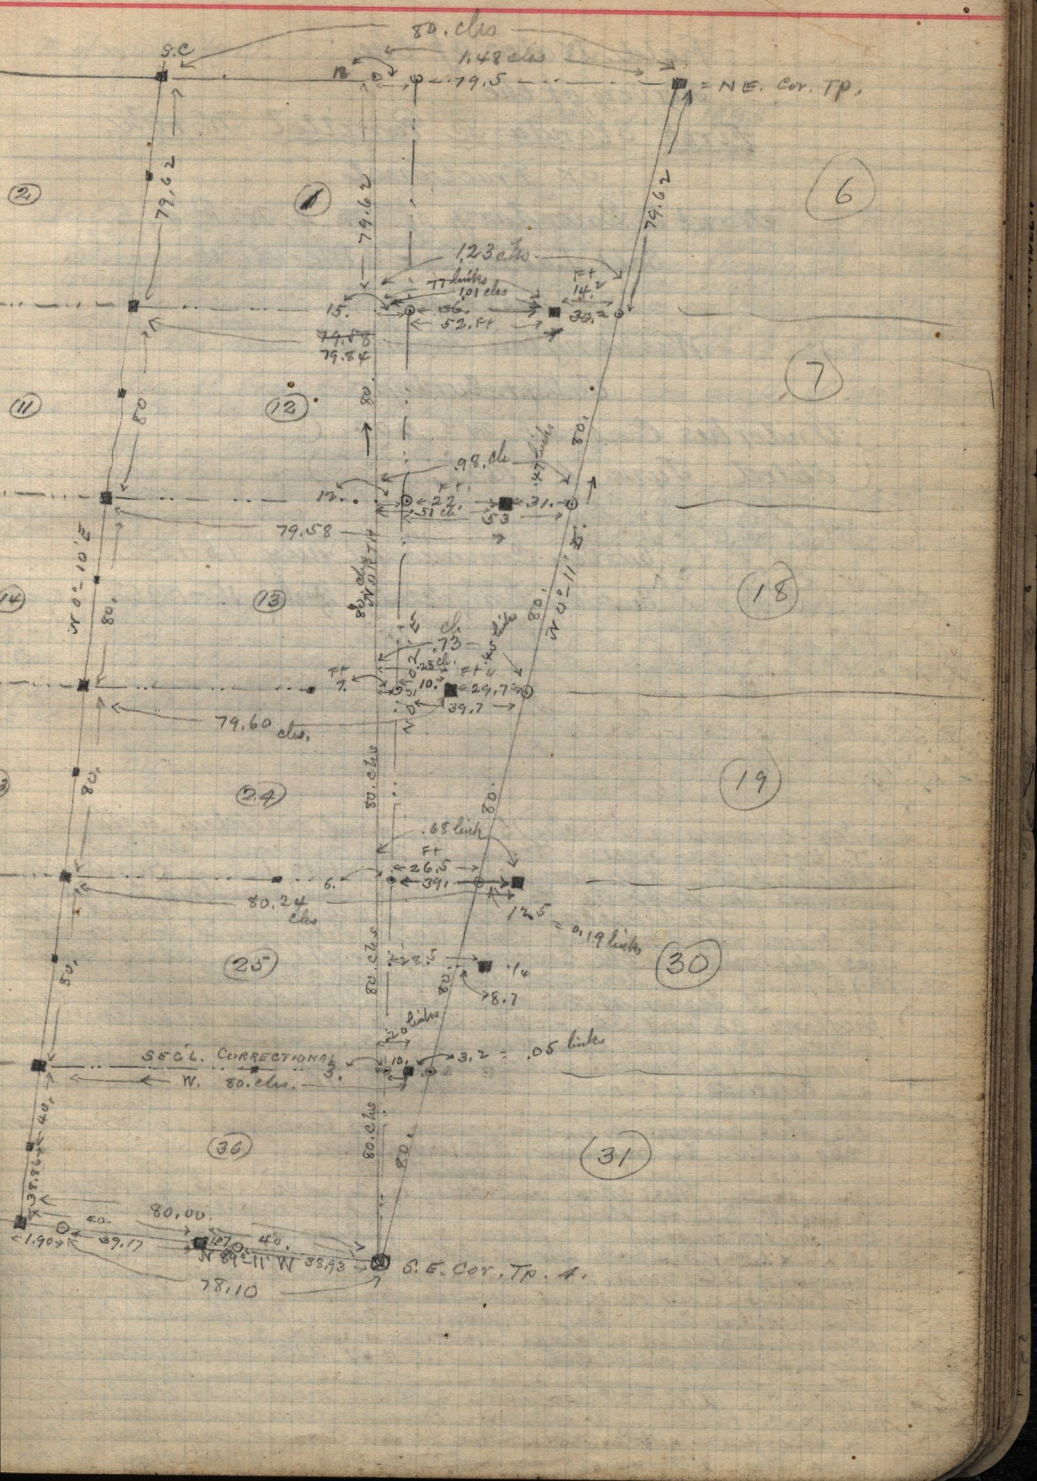
80. chs
S.C
1.48 chs
79.5
= N.E. Cor. TP.
79.62
6
1.23 chs
77 links
101 chs
52. Ft
7
98. chs
47 links
79.58
53
18
.73
39.7
79.60 chs.
19
.68 link
26.5
80.24 chs
.19 links
30
.14
8.7
SEC'L. CORRECTIONS
W. 80. chs.
.05 links
36
31
80.00
89.17
1.90
N 89° 11' W 38.93
78.10
S. E. Cor. TP. 4.