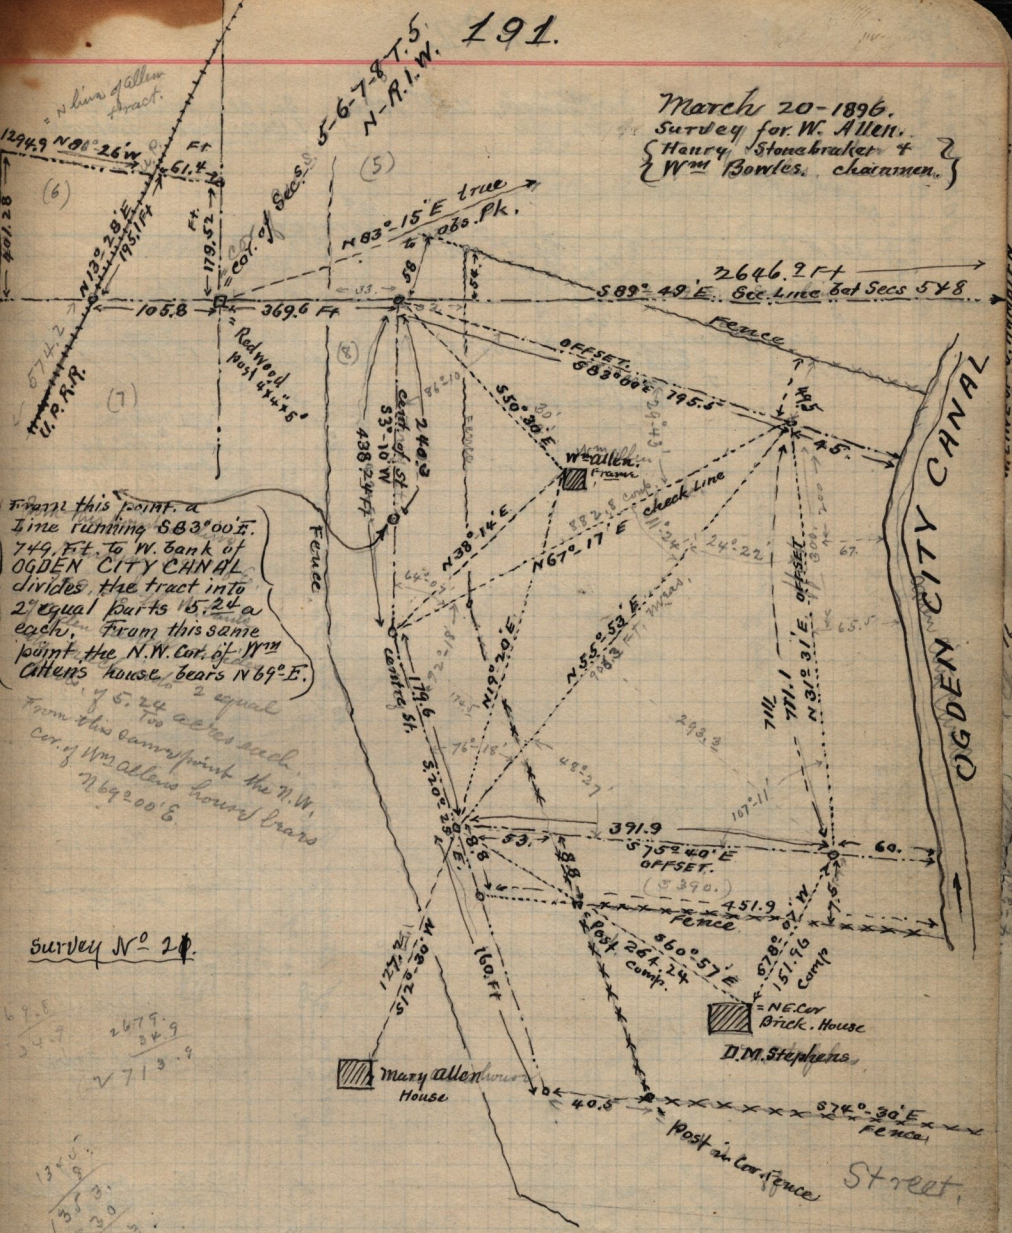

10.48 a not including street

6-449. Thos. Doxey to E. F. Tout. - Pt. Lots 5-6. B. 5. P. A. O.C.S. Beg. N.W. cor. of E ½ of said lot. E. 55. Ft. S. 16. rods to S. line of lot 5. W. 55. ft N. to beg.

surveyed April 4th 1896.
see page 172 -