


March 21st 1896, Survey made for T. Heninger Estate.

158385 Ft. → 67 1/2 W. N. R.I.W. 21.

see Field Book I. page 149.

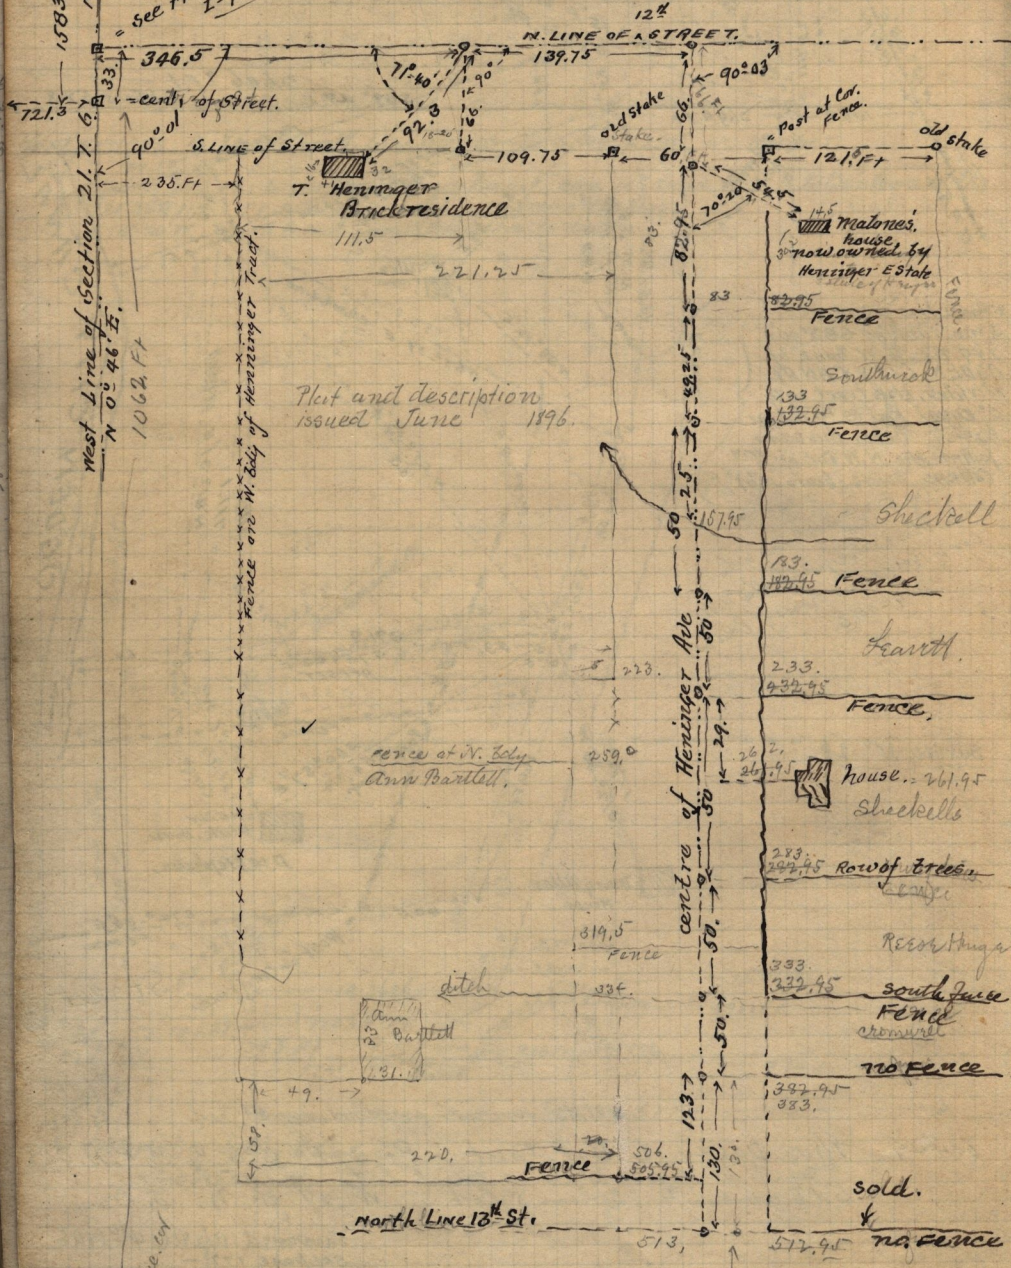

To 21.5 T.5

West Line of Section 21 T. 6 N 00 46' E. 1062 Ft.

fence and N. Body of Heninger tract.

Plat and description issued June 1896.

fence of N. Body Ann Bartlett.

Ann Bartlett

House 261.95 Sheds

Row of Trees

Recor. King

south fence Fence

no fence

sold.

no fence

To E. line