March 26th 1896.
Survey of Riverdale school Lot, for J. N. Hamblen & others.

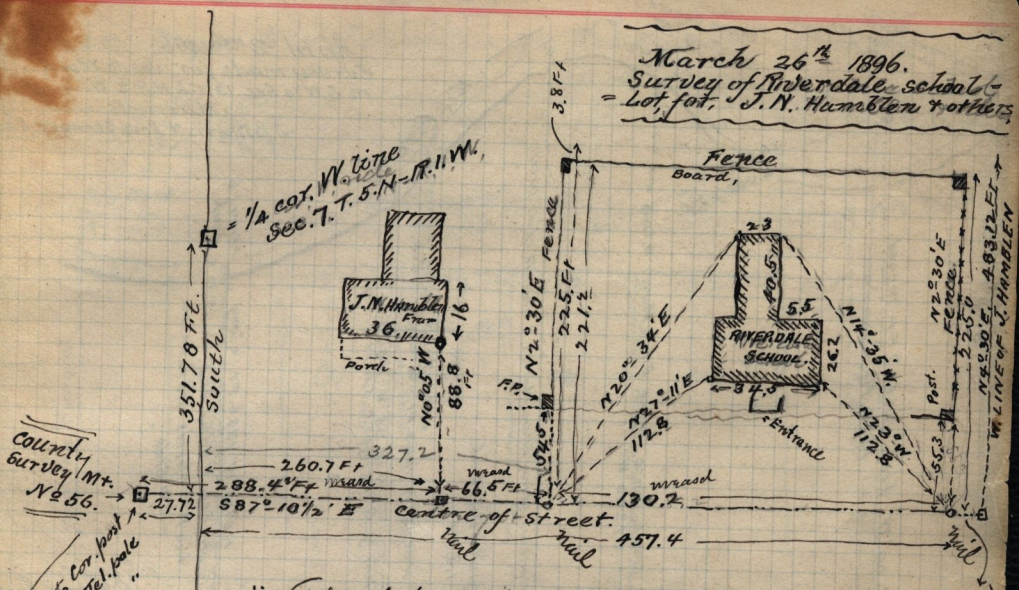

SCHOOL-LOT.

Copy of description entered in deed from Sanford Bingham to School Trustees of Riverdale School Dist. Apr. 1-1896. Pt. S. W 1/4 Sec. 7. T. 5. N - R. 1. W. Beg. 351.78 Ft. S. and 327.2 Ft. S 87°10' E from N.W. cor. in cent. of St. Running thence N 2°30' E. 225. Ft. thence S. 87°10' E. 132.16 Ft. S 2°30' W. 225. Ft. to cent. St. N 87°10' W. 132.16 Ft. to beg. .68 of 1. a. to correct former deed. dated. Jan. 23-73 & recorded. in Book H. on page 247. Weber Co. Records.

E. 71.7 Ft. to Cor. post
S.E. 86.75 " " Tel. pole
S.W. 87.8 " " "
N 79°04' E. 085. pk.
St. runs S 87°-10'-30" E

J-138-146-
F-2-27-250
L-3-
I-81-
G-100-118-126
PLAT-Book 123

W. bdy. Tp. 5. N - R. 1. W.

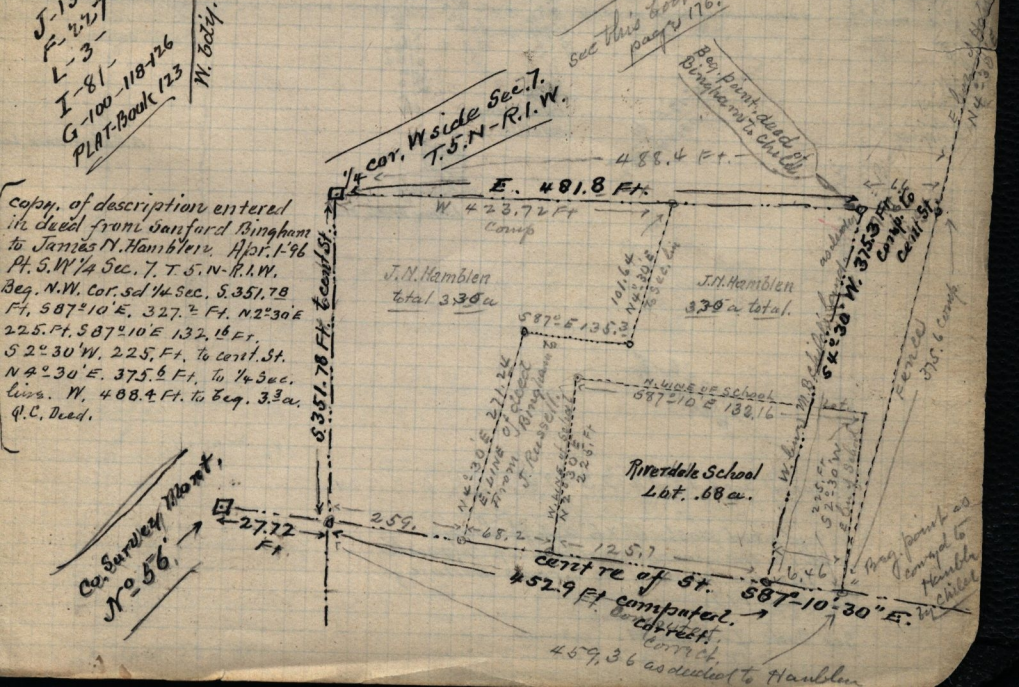

copy. of description entered in deed from Sanford Bingham to James N. Hamblen. Apr. 1'96 Pt. S. W 1/4 Sec. 7. T. 5. N - R. 1. W. Beg. N.W. Cor. Sd 1/4 Sec. S. 351.78 Ft. S 87°10' E. 327.½ Ft. N 2°30' E 225. Ft. S 87°10' E 132.16 Ft. S 2°30' W. 225. Ft. to cent. St. N 4°-30' E. 375.6 Ft. To 1/4 Sec. Line. W. 488.4 Ft. to beg. 3.3 a. R.C. Deed.